

CARD MUST BE SIGNED

099-22,152-00-00

SE...NW...NE. Sec...8...Twp 33...S, Rge 19. ☐ West

1.....4290... Ft North from Southeast Corner of Section

.....1650.... Ft West from Southeast Corner of Section

(Note: Locate well on Section Plat on reverse side)

Nearest lease or unit boundary line990..... feet.

County **Labette**

Lease Name ...Harwood..... Well# 8-31A.

Domestic well within 330 feet : ☐ yes ☒ no

Municipal well within one mile : ☐ yes ☒ no

Depth to Bottom of fresh water None feet

Lowest usable water formation None

Depth to Bottom of usable water 150 feet

Surface pipe by Alternate : 1 ☐ 2 ☒

Surface pipe to be set 20 feet

Conductor pipe if any required None feet

Ground surface elevation feet MSL

This Authorization Expires 3-24-85

Approved By 9-24-84 

Date 9/19/84 Signature of Operator or Agent _____

Title General Manager


Form C-1 4/84

МНС/УДНЕ 9/24/84

Must be filed with the K.C.C. five (5) days prior to commencing well
This card void if drilling not started within six (6) months of date received by K.C.C.

Important procedures to follow :

**A Regular Section of Land
1 Mile = 5,280 Ft.**

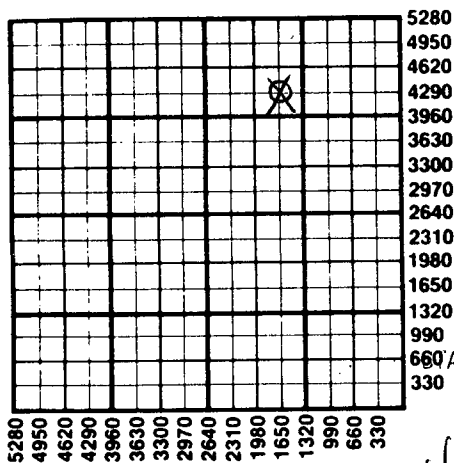

1. Notify District office before setting surface casing.
2. Set surface casing by circulating cement to the top.
3. File completion forms ACO-1 with K.C.C. within 90 days of well completion, following instructions on ACO-1, side 1, and including copies of wireline logs.
4. Notify District office 48 hours prior to old well workover or re-entry.
5. Prior to plugging, prepare a plugging plan, then obtain agreement from the appropriate district office for an approved plugging plan.
6. Submit plugging report (CP-4) to K.C.C. after plugging is completed.
7. Obtain an approved injection docket number before disposing of salt water.
8. Notify K.C.C. within 10 days when injection commences or terminates.
9. If an alternate completion, cement in the production pipe from below any usable water to surface within 120 days of spud date.

RECEIVED

SEP 24 1984

CONSERVATION DIVISION
Wichita, Kansas

State Corporation Commission of Kansas
Conservation Division
200 Colorado Derby Building
Wichita, Kansas 67202
(316) 263-3238

924-84