

CARD MUST BE TYPED

State of Kansas

CARD MUST BE SIGNED

# NOTICE OF INTENTION TO DRILL

(see rules on reverse side)

Expected Spud Date..... 9<sup>th</sup> 8<sup>th</sup> 87<sup>th</sup>  
month day year

API Number 15- 125-28,644-00-00

OPERATOR: License # 4469  
Name KELT OIL & GAS INC.  
Address 900 COLLEGE AVE.  
City/State/Zip INDEPENDENCE, KS. 67301  
Contact Person PETE JOHNSON  
Phone 316-331-0207

NW SW SW Sec. 12 Twp. 34 S. Rg. 13E — East  
1155 — West  
5115 Ft. from South Line of Section  
Ft. from East Line of Section

(Note: Locate well on Section Plat on reverse side)

CONTRACTOR: License #  
Name UNKNOWN  
City/State

Nearest lease or unit boundary line 165 feet  
County MONTGOMERY  
Lease Name PENDLETON Well # KHHE 5

Well Drilled For: Well Class: Type Equipment:  
 Oil  Storage  Infield  Mud Rotary  
 Gas  Inj  Pool Ext.  Air Rotary  
 OWWO  Expl  Wildcat  Cable

Ground surface elevation feet MSL  
Domestic well within 330 feet:  yes  no  
Municipal well within one mile:  yes  no

If OWWO: old well info as follows:  
Operator  
Well Name  
Comp Date Old Total Depth

Depth to bottom of fresh water.  
Depth to bottom of usable water 175  
Surface pipe by Alternate: 1 2   
Surface pipe planned to be set 20  
Conductor pipe required NA  
Projected Total Depth 900 feet  
Formation WEISER

I certify that well will comply with K.S.A. 55-101, et seq., plus eventually plugging hole to KCC specifications.

Date 9-2-87 Signature of Operator or Agent *P. Johnson* Title Agent

For KCC Use:

Conductor Pipe Required feet; Minimum Surface Pipe Required 20 feet per Alt. X 2

This Authorization Expires 3-8-88 Approved By *John* 9-8-87


Effective 9-13-87

Must be filed with the K.C.C. five (5) days prior to commencing well  
 This card void if drilling not started within six (6) months of date received by K.C.C.

**Important procedures to follow:**

1. Notify District office before setting surface casing.
2. Set surface casing by circulating cement to the top.
3. File completion forms ACO-1 with K.C.C. within 120 days of well spud date, following instructions on ACO-1, side 1, and including copies of wireline logs.
4. Notify District office 48 hours prior to old well workover or re-entry.
5. Prior to filing Intent, prepare a proposed plugging plan in case well is D & A, then obtain approval of plan when calling district office prior to setting surface pipe.
6. Submit plugging report (CP-4) to K.C.C. after plugging is completed.
7. Obtain an approved injection docket number before disposing of salt water.
8. Notify K.C.C. within 10 days when injection commences or terminates.
9. If an alternate 2 completion, cement in the production pipe from below any usable water to surface within 120 days of spud date.

**A Regular Section of Land**  
 1 Mile = 5,280 Ft.

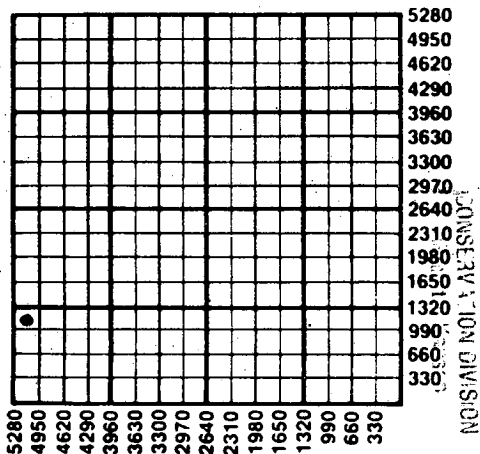

SEP 4 1987

9-4-87

STATE CORPORATION COMMISSION

REGISTRATION

State Corporation Commission of Kansas  
 Conservation Division  
 200 Colorado Derby Building  
 Wichita, Kansas 67202-1212  
 (316) 263-3238