

CARD MUST BE TYPED

State of Kansas

CARD MUST BE SIGNED

NOTICE OF INTENTION TO DRILL

(see rules on reverse side)

Expected Spud Date... Sept. 29, 1987
month day yearAPI Number 15— 125-28,822-00-00OPERATOR: License # 4469Name Kelt Energy Inc.Address 900 College Ave.City/State/Zip Independence, Kansas 67301Contact Person Pete JohnsonPhone (316) 331-0207

CONTRACTOR: License #

Name Unknown

City/State

Well Drilled For:

☒ Oil ☐ Storage ☒ Infield ☒ Mud Rotary☐ Gas ☐ Inj. ☐ Pool Ext. ☐ Air Rotary☐ OWWO ☐ Expl ☐ Wildcat ☐ Cable

If OWWO: old well info as follows:

Operator

Well Name

Comp Date Old Total Depth

I certify that well will comply with K.S.A. 55-101, et seq., plus eventually plugging hole to KCC specifications.

Date 9-23-87. Signature of Operator or Agent B. J. Phillips Title Agent

For KCC Use:

Conductor Pipe Required _____ feet; Minimum Surface Pipe Required 20 feet per Alt. 1 (2)This Authorization Expires 3-28-88 signature Approved By signature 9-28-87

_____ East

SW SW SW Sec. 14 Twp. 34 S, Rg. 13 _____ West495 Ft. from South Line of Section4785 Ft. from East Line of Section

(Note: Locate well on Section Plat on reverse side)

Nearest lease or unit boundary line 165 feetCounty MontgomeryLease Name Patterson Well # KHHP 34

Ground surface elevation _____ feet MSL

Domestic well within 330 feet: _____ yes ☒ noMunicipal well within one mile: _____ yes ☒ no

Depth to bottom of fresh water _____

Depth to bottom of usable water 175Surface pipe by Alternate: 1 _____ 2 ☒Surface pipe planned to be set 20Conductor pipe required NAProjected Total Depth 1000 feetFormation Weiser

Must be filed with the K.C.C. five (5) days prior to commencing well
This card void if drilling not started within six (6) months of date received by K.C.C.


Important procedures to follow:

1. Notify District office before setting surface casing.
 2. Set surface casing by circulating cement to the top.
 3. File completion forms ACO-1 with K.C.C. within 120 days of well spud date, following instructions on ACO-1, side 1, and including copies of wireline logs.
 4. Notify District office 48 hours prior to old well workover or re-entry.
 5. Prior to filing Intent, prepare a proposed plugging plan in case well is D & A, then obtain approval of plan when calling district office prior to setting surface pipe.
 6. Submit plugging report (CP-4) to K.C.C. after plugging is completed.
- Obtain an approved injection docket number before disposing of salt water.
- Notify K.C.C. within 10 days when injection commences or terminates.

an alternate 2 completion, cement in the production pipe from below any usable water to surface within 120 days of spud date.

State Corporation Commission of Kansas
Conservation Division
200 Colorado Derby Building
Wichita, Kansas 67202-1212
(316) 263-3238

A Regular Section of Land 1 Mile = 5,280 Ft.

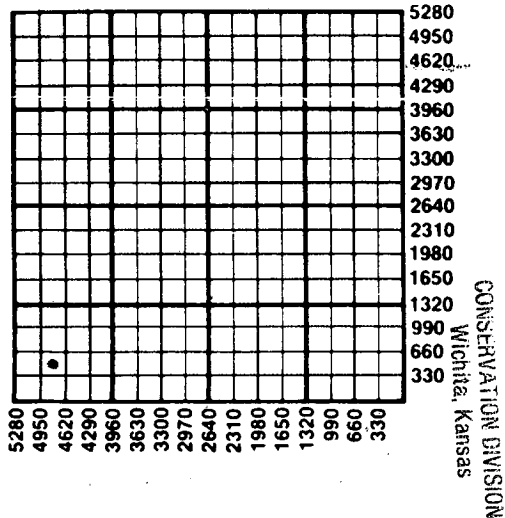

SEP 25 1987

STATE CORPORATION COMMISSION

RECEIVED

9-25-87