

CARD MUST BE SIGNED

API Number 15- 099-22,368-00-00

☐ East
 . NW. NW. NE. Sec . 7. Twp . 32 S, Rge . 21 ☒ West
 (location)

.2475..... Ft North from Southeast Corner of Section
...350..... Ft West from Southeast Corner of Section
 (Note: Locate well on Section Plat on reverse side)

Nearest lease or unit boundary line ... 165 feet.
County ... Labette
Lease Name Marvin Czapansky. Well# ... 10
Domestic well within 330 feet : ☐ yes ☒ no
Municipal well within one mile : ☐ yes ☒ no

Depth to Bottom of fresh water 36 MHC..... feet
Lowest usable water formation 100..... feet
Depth to Bottom of usable water 100..... feet
Surface pipe by Alternate : 1 ☐ 2 ☒
Surface pipe to be set 23..... feet
Conductor pipe if any required ... NONE..... feet
Ground surface elevation 535..... feet MSL
This Authorization Expires 2-21-86
Approved By RCH 8-21-85


Date .. 8/19/1985 Signature of Operator or Agent

..... Title owner

Must be filed with the K.C.C. five (5) days prior to commencing well
This card void if drilling not started within six (6) months of date received by K.C.C.

Important procedures to follow :

A Regular Section of Land
1 Mile = 5,280 Ft.

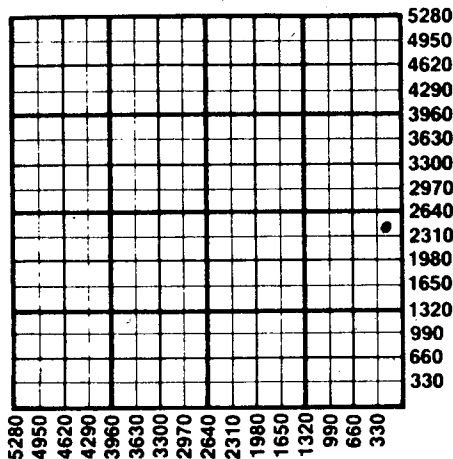

1. Notify District office before setting surface casing.
2. Set surface casing by circulating cement to the top.
3. File completion forms ACO-1 with K.C.C. within 90 days of well completion, following instructions on ACO-1, side 1, and including copies of wireline logs.
4. Notify District office 48 hours prior to old well workover or re-entry.
5. Prior to plugging, prepare a plugging plan, then obtain agreement from the appropriate district office for an approved plugging plan.
6. Submit plugging report (CP-4) to K.C.C. after plugging is completed.
7. Obtain an approved injection docket number before disposing of salt water.
8. Notify K.C.C. within 10 days when injection commences or terminates.
9. If an alternate 2 completion, cement in the production pipe from below any usable water to surface within 120 days of spud date.

State Corporation Commission of Kansas
Conservation Division
200 Colorado Derby Building
Wichita, Kansas 67202
(316) 263-3238

RECEIVED
STATE CORPORATION COMMISSION
AUG 21 1985
8-21-85