

CARD MUST BE SIGNED

Starting Date: 3/.....8/.....'85.....
month day year

API Number 15- 099-22, 298-00-00
NE ☐ East

OPERATOR: License # 8462
Name Loren Smith
Address Rt. 1
City/State/Zip Oswego, KS 67356
Contact Person Loren Smith
Phone 316-827-6264

NW.. NW..~~12~~ Sec..8. Twp..38, Rge..21 ☒ West
(Location)

.49.50..... Ft North from Southeast Corner of Section
...25.52..... Ft West from Southeast Corner of Section
(Note: Locate well on Section Plat on reverse side)

CONTRACTOR: License # 8462
Name Loren Smith
City/State Oswego, KS

Nearest lease or unit boundary line ... 330 feet.
County ... Labette
Lease Name Marvin Czapansky.. Well# 9.....
Domestic well within 330 feet : ☐ yes ☒ no
Municipal well within one mile : ☐ yes ☒ no

Well Drilled For:	Well Class:	Type Equipment:
☒ Oil ☐ Swd	☒ Infield	☐ Mud Rotary
☐ Gas ☐ Inj	☐ Pool Ext.	☐ Air Rotary
☐ OWWO ☐ Expl	☐ Wildcat	☒ Cable

Depth to Bottom of fresh water 36 MHC feet
Lowest usable water formation none
Depth to Bottom of usable water 100 feet
Surface pipe by Alternate: 1 ☐ 2 ☒
Surface pipe to be set 23 feet
Conductor pipe if any required none feet
Ground surface elevation 535 feet MSL
This Authorization Expires 9-5-85
Approved By 3-5-85 

If OWWO: old well info as follows:

Operator

Well Name

Comp Date **Old Total Depth**

Projected Total Depth 700 feet

Projected Formation at TD

Expected Producing Formations

I certify that we will comply with K.S.A. 55-101, et seq., plus eventually plugging hole to K.C.C. specifications.

Date 1/4/85 Signature of Operator or Agent Karen Smith Title owner

Form C-1 4/84


МНС/КОДЕ 3-5-85

Must be filed with the K.C.C. five (5) days prior to commencing well
This card void if drilling not started within six (6) months of date received by K.C.C.

Important procedures to follow :

A Regular Section of Land

1-Mile = 5,280 Ft.

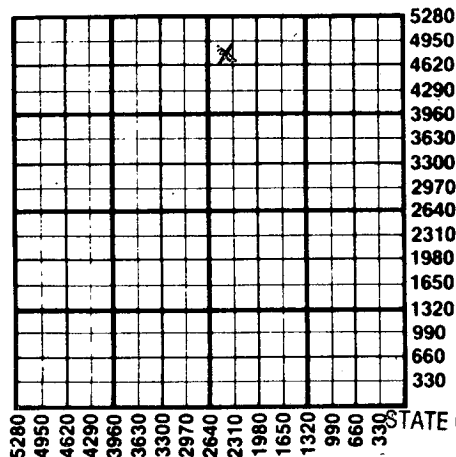

1. Notify District office before setting surface casing.
2. Set surface casing by circulating cement to the top.
3. File completion forms ACO-1 with K.C.C. within 90 days of well completion, following instructions on ACO-1, side 1, and including copies of wireline logs.
4. Notify District office 48 hours prior to old well workover or re-entry.
5. Prior to plugging, prepare a plugging plan, then obtain agreement from the appropriate district office for an approved plugging plan.
6. Submit plugging report (CP-4) to K.C.C. after plugging is completed.
7. Obtain an approved injection docket number before disposing of salt water.
8. Notify K.C.C. within 10 days when injection commences or terminates.
9. If an alternate 2 completion, cement in the production pipe from below any usable water to surface within 120 days of spud date.

RECEIVED

STATE CORPORATION COMMISSION

State Corporation Commission of Kansas

Conservation Division

200 Colorado Derby Building

Wichita, Kansas 67202

(316)263-3238

CONSERVATION DIVISION
Wichita, Kansas

MAR 05 1985

3S-8S