

CARD MUST BE TYPED

"CORRECTION"

NOTICE OF INTENTION TO DRILL

State of Kansas
(see rules on reverse side)

Correction
7-25-85
CARD MUST BE SIGNED

Starting Date: JULY 11, 1985
month day year

API Number 15- 125-27,852- 00-00

OPERATOR: License # 9455
Name W. H. SMITHER II
Address P.O. BOX 926
City/State/Zip MESA, ARIZONA 85201
Contact Person PAUL BARNES
Phone (316) 289-4766

SE. SW. SE Sec. 2. Twp. 34 S, Rge. 14 East West
(location)

* .330! Ft North from Southeast Corner of Section
* 1,650! Ft West from Southeast Corner of Section
(Note: Locate well on Section Plat on reverse side)

CONTRACTOR: License # 6485
Name RAYGARY OIL CO.
City/State HAVANNA, KANSAS

* Nearest lease or unit boundary line .330! feet.
County MONTGOMERY
Lease Name LINDLEY/BAKER Well# 12

Well Drilled For: Well Class: Type Equipment:
 Oil Swd Infield Mud Rotary
 Gas Inj Pool Ext. Air Rotary
 OWWO Expl Wildcat Cable

Domestic well within 330 feet: yes no
Municipal well within one mile: yes no

If OWWO: old well info as follows:
Operator
Well Name
Comp Date Old Total Depth
Projected Total Depth 750! feet
Projected Formation at TD WAYSIDE
Expected Producing Formations WAYSIDE

Depth to Bottom of fresh water feet
Lowest usable water formation
Depth to Bottom of usable water 175 feet
Surface pipe by Alternate: 1 2
Surface pipe to be set 20! feet
Conductor pipe if any required feet
Ground surface elevation 840 ESTIMATE feet MSL.
This Authorization Expires 12-17-85
Approved By R.H. 7-25-85 6-17-85 → O.P.I.B. PCV'D

I certify that we will comply with K.S.A. 55-101, et seq., plus eventually plugging hole to K.C.C. specifications.

Date 7-22-85 Signature of Operator or Agent

W. H. Smither II

Title OWNER/OPERATOR


* WAS: 440' FSL
1540' FEL
440' FROM LEASE LINE

Must be filed with the K.C.C. five (5) days prior to commencing well
 This card void if drilling not started within six (6) months of date received by K.C.C.

CONSERVATION DIVISION
 WICHITA, KANSAS

RECEIVED
 STATE CORPORATION COMMISSION
 APR 25 1985

A Regular Section of Land
 1 Mile = 5,280 Ft.

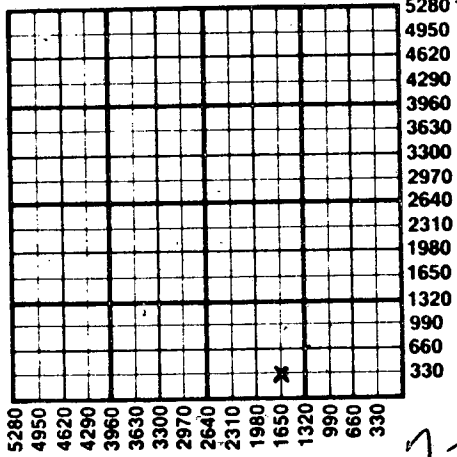

7-25-85

Important procedures to follow:

1. Notify District office before setting surface casing.
2. Set surface casing by circulating cement to the top.
3. File completion forms ACO-1 with K.C.C. within 90 days of well completion, following instructions on ACO-1, side 1, and including copies of wireline logs.
4. Notify District office 48 hours prior to old well workover or re-entry.
5. Prior to plugging, prepare a plugging plan, then obtain agreement from the appropriate district office for an approved plugging plan.
6. Submit plugging report (CP-4) to K.C.C. after plugging is completed.
7. Obtain an approved injection docket number before disposing of salt water.
8. Notify K.C.C. within 10 days when injection commences or terminates.
9. If an alternate 2 completion, cement in the production pipe from below any usable water to surface within 120 days of spud date.

State Corporation Commission of Kansas
 Conservation Division
 200 Colorado Derby Building
 Wichita, Kansas 67202
 (316) 263-3238