

CARD MUST BE TYPED

State of Kansas

CARD MUST BE SIGNED

NOTICE OF INTENTION TO DRILL

(see rules on reverse side)

Expected Spud Date.....08/31/88.....
month day year

API Number 15—125-29,085-0000

OPERATOR: License #.....5396.....
 Name.....A R T & M CO., INC.....
 Address.....BOX 1.....
 City/State/Zip.....TYRO, 67364.....
 Contact Person.....MIKE MELANDER.....
 Phone.....(316) 289-4633.....

CONTRACTOR: License #.....5989.....
 Name.....FINNEY DRILLING COMPANY.....
 City/State.....RT. 1 WANN, OK 74083.....

Well Drilled For: Well Class: Type Equipment:
☒ Oil ☐ Storage ☒ Infield ☒ Mud Rotary
☐ Gas ☐ Inj ☐ Pool Ext. ☐ Air Rotary
☐ OWWO ☐ Expl ☐ Wildcat ☐ Cable

If OWWO: old well info as follows:

Operator.....
 Well Name.....
 Comp Date..... Old Total Depth.....

I certify that well will comply with K.S.A. 55-101, et seq., plus eventually plugging hole to KCC specifications.

Date 08/30/88..... Signature of Operator or Agent

Jon Engleman Title.....
as agent

For KCC Use:

Conductor Pipe Required.....feet; Minimum Surface Pipe Required.....feet per Alt. ☒ (2)
 This Authorization Expires.....3-1-89..... Approved By *LM* 8-30-88.....

EFFECTIVE DATE: 9-4-88

NW NE SW Sec. 2... Twp. 34... S, Rg. 14... ☒ East
 2310 Ft. from South Line of Section
 3795 Ft. from East Line of Section

(Note: Locate well on Section Plat on reverse side)


Nearest lease or unit boundary line.....1485.... feet
 County.....MONTGOMERY.....
 Lease Name.....HOME PLACE.... Well #.....1..
 Ground surface elevation.....750..... feet MSL
 Domestic well within 330 feet: ☐ yes ☒ no
 Municipal well within one mile: ☐ yes ☒ no
 Depth to bottom of fresh water. 145.....
 Depth to bottom of usable water 175.....
 Surface pipe by Alternate: 1 ☒
 Surface pipe planned to be set.....20.....
 Conductor pipe required.....
 Projected Total Depth.....1600..... feet
 Formation.....MISSISSIPPI.....

Must be filed with the K.C.C. five (5) days prior to commencing well
This card void if drilling not started within six (6) months of date received by K.C.C.

Important procedures to follow:

1. Notify District office before setting surface casing.
2. Set surface casing by circulating cement to the top.
3. File completion forms ACO-1 with K.C.C. within 120 days of well spud date, following instructions on ACO-1, side 1, and including copies of wireline logs.
4. Notify District office 48 hours prior to old well workover or re-entry.
5. Prior to filing Intent, prepare a proposed plugging plan in case well is D & A, then obtain approval of plan when calling district office prior to setting surface pipe.
6. Submit plugging report (CP-4) to K.C.C. after plugging is completed.
7. Obtain an approved injection docket number before disposing of salt water.
8. Notify K.C.C. within 10 days when injection commences or terminates.
9. If an alternate 2 completion, cement in the production pipe from below any usable water to surface within 120 days of spud date.

A Regular Section of Land 1 Mile = 5,280 Ft.

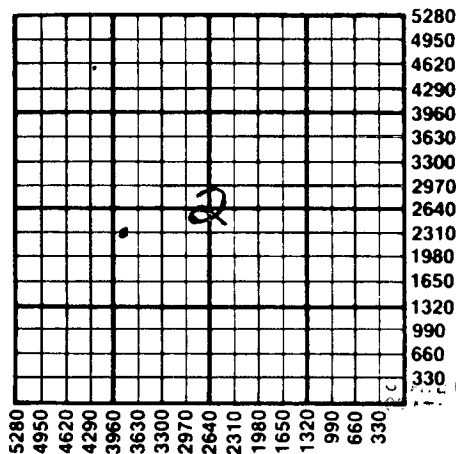

RECEIVED
STATE CORPORATION COMMISSION

CONSERVATION DIVISION
Wichita, Kansas

8-30-88

State Corporation Commission of Kansas
Conservation Division
200 Colorado Derby Building
Wichita, Kansas 67202-1212
(316) 263-3238