

CARD MUST BE TYPED

State of Kansas
NOTICE OF INTENTION TO DRILL
(see rules on reverse side)

CARD MUST BE SIGNED

Starting Date: 4 2 85
month day year 11:10

API Number 15- 003-22,607-00-00

OPERATOR: License # 9558
Name Simca Oil, Inc.
Address 10720 Horton
City/State/Zip Overland Park, KS 66211
Contact Person Rick Andrews
Phone (913) 341-8459

..NW..SW..SW.. Sec20.. Twp..22 S, Rge..20 East
(location) West
.....1.155..... Ft North from Southeast Corner of Section
.....5.115..... Ft West from Southeast Corner of Section
(Note: Locate well on Section Plat on reverse side)

CONTRACTOR: License # 6913
Name Casady Drilling Co.
City/State Ottawa, KS 66067

Nearest lease or unit boundary line 165 feet.
County Anderson
Lease Name Church Well# 1-E
Domestic well within 330 feet: yes no
Municipal well within one mile: yes no

Well Drilled For: Well Class: Type Equipment:
 Oil Swd Infield Mud Rotary
 Gas Inj Pool Ext. Air Rotary
 OWWO Expl Wildcat Cable

Depth to Bottom of fresh water ...7.5..... feet
Lowest usable water formation
Depth to Bottom of usable water ..1.50..... feet
Surface pipe by Alternate: 1 2
Surface pipe to be set20..... feet
Conductor pipe if any required feet
Ground surface elevation feet MSL
This Authorization Expires

If OWWO: old well info as follows:
Operator
Well Name
Comp Date Old Total Depth
Projected Total Depth1200..... feet
Projected Formation at TDMississippian.....
Expected Producing Formations

Approved By 4-1-85
10-1-85
Ra

I certify that we will comply with K.S.A. 55-101, et seq., plus eventually plugging hole to K.C.C. specifications.

Date 4/1/85 Signature of Operator or Agent *Raquel Robles* Title As Agent

mhc/UDHE 4-1-85

Must be filed with the K.C.C. five (5) days prior to commencing well
This card void if drilling not started within six (6) months of date received by K.C.C.


Wichita, Kansas

CONSERVATION DIVISION

58-10-50
 APR 1 1985
 STATE COMMISSION OF LAND
 A Regular Section of Land
 36 1/4 Acre 1/4 Section
 1 Mile 280 Ft.

Important procedures to follow:

1. Notify District office before setting surface casing.
2. Set surface casing by circulating cement to the top.
3. File completion forms ACO-1 with K.C.C. within 90 days of well completion, following instructions on ACO-1, side 1, and including copies of wireline logs.
4. Notify District office 48 hours prior to old well workover or re-entry.
5. Prior to plugging, prepare a plugging plan, then obtain agreement from the appropriate district office for an approved plugging plan.
6. Submit plugging report (CP-4) to K.C.C. after plugging is completed.
7. Obtain an approved injection docket number before disposing of salt water.
8. Notify K.C.C. within 10 days when injection commences or terminates.
9. If an alternate 2 completion, cement in the production pipe from below any usable water to surface within 120 days of spud date.

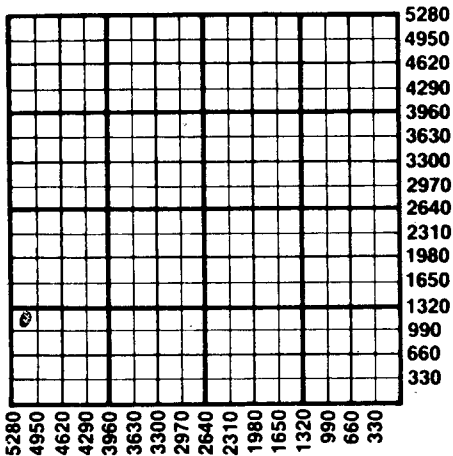

State Corporation Commission of Kansas
Conservation Division
200 Colorado Derby Building
Wichita, Kansas 67202
(316) 263-3238