

EFFECTIVE DATE: 11-5-91

FC

FORM C-1 4/91

FORM MUST BE TYPED

FORM MUST BE SIGNED

ALL BLANKS MUST BE FILLED

DISTRICT # 4

State of Kansas

NOTICE OF INTENTION TO DRILL

SGA? ... Yes No

Must be approved by the K.C.C. five (5) days prior to commencing well

Expected Spud Date November 10 1991
month day year

Spot SW SW SE Sec 17 Twp 8 S. Rg 18 East West

OPERATOR: License # 30722
Name: Edwin C. Schuett & Sharp Engineering
Address: 1616 Glenarm Place #1804
City/State/Zip: Denver CO 80202
Contact Person: Gary Sharp
Phone: 316-733-1989

330 feet from South / North line of Section
2310 feet from East / West line of Section
IS SECTION REGULAR IRREGULAR?

(NOTE: Locate well on the Section Plat on Reverse Side)

County: Rooks
Lease Name: Rostocil Well #: 1
Field Name: Sweet Southeast

CONTRACTOR: License #: 8241
Name: Emphasis Oil Operations

Is this a Prorated/Spaced Field? ... yes ... no X
Target Formation(s): Arbuckle

Well Drilled For: Well Class: Type Equipment:
 Oil ... Enh Rec Infield Mud Rotary
... Gas ... Storage ... Pool Ext. ... Air Rotary
... OWWO ... Disposal ... Wildcat ... Cable
... Seismic: ... # of Holes ... Other
... Other

Nearest lease or unit boundary: 330
Ground Surface Elevation: est 2035 feet MSL

Domestic well within 330 feet: ... yes X. no
Municipal well within one mile: ... yes X. no

Depth to bottom of fresh water: 120
Depth to bottom of usable water: 930

Surface Pipe by Alternate: ... 1 X 2

Length of Surface Pipe Planned to be set: 240

Length of Conductor pipe required: N/A

Projected Total Depth: 3500

Formation at Total Depth: Arbuckle

Water Source for Drilling Operations:
... well X. farm pond ... other

If OWWO: old well information as follows:
Operator: _____
Well Name: _____
Comp. Date: _____ Old Total Depth _____

DWR Permit #: _____

Will Cores Be Taken?: X yes ... no

If yes, proposed zone: Arbuckle

Directional, Deviated or Horizontal wellbore? ... yes X. no

If yes, total depth location: _____

Bottom Hole Location: _____

AFFIDAVIT

The undersigned hereby affirms that the drilling, completion and eventual plugging of this well will comply with K.S.A. 55-101, et. seq.

It is agreed that the following minimum requirements will be met:

1. Notify the appropriate district office prior to spudding of well;
2. A copy of the approved notice of intent to drill shall be posted on each drilling rig;
3. The minimum amount of surface pipe as specified below shall be set by circulating cement to the top; in all cases surface pipe shall be set through all unconsolidated materials plus a minimum of 20 feet into the underlying formation;
4. If the well is dry hole, an agreement between the operator and the district office on plug length and placement is necessary prior to plugging;
5. The appropriate district office will be notified before well is either plugged or production casing is cemented in;
6. IF AN ALTERNATE II COMPLETION, PRODUCTION PIPE SHALL BE CEMENTED FROM BELOW ANY USABLE WATER TO SURFACE WITHIN 120 DAYS OF SPUD DATE. IN ALL CASES, NOTIFY DISTRICT OFFICE PRIOR TO ANY CEMENTINGS.

I hereby certify that the statements made herein are true and to the best of my knowledge and belief.

Date: October 28, 1991 Signature of Operator or Agent: Edwin C. Schuett Title: Operator

RECEIVED
STATE CORPORATION COMMISSION

OCT 30 1991
DIVISION
Wichita, Kansas

FOR KCC USE:
 API # 15- 163-23188-00-00
 Conductor pipe required None feet
 Minimum surface pipe required 200 feet per Alt. 4 (2)
 Approved by: mw 10-31-91
 This authorization expires: 4-30-92
 (This authorization void if drilling not started within 6 months of effective date.)
 Spud date: _____ Agent: _____

REMEMBER TO:

- File Drill Pit Application (form CDP-1) with Intent to Drill;
- File Completion Form ACO-1 within 120 days of spud date;
- File acreage attribution plat according to field proration orders;
- Notify appropriate district office 48 hours prior to workover or re-entry;
- Submit plugging report (CP-4) after plugging is completed;
- Obtain written approval before disposing or injecting salt water.

Mail to: Conservation Division, 200 Colorado Derby Building, 202 W. First St., Wichita, Kansas 67202-1286.

12
8
1800

IN ALL CASES PLOT THE INTENDED WELL ON THE PLAT BELOW

PLAT OF ACREAGE ATTRIBUTABLE TO A WELL IN A PRORATED OR SPACED FIELD

If the intended well is in a prorated or spaced field, please fully complete this side of the form. If the intended well is in a prorated or spaced field complete the plat below showing that the well will be properly located in relationship to other wells producing from the common source of supply. Please show all the wells within 1 mile of the boundaries of the proposed acreage attribution unit for gas wells and within 1/2 mile of the boundaries of the proposed acreage attribution unit for oil wells.



API NO. 15- _____
 OPERATOR _____ LOCATION OF WELL: COUNTY _____
 LEASE _____ feet from south/north line of section _____
 WELL NUMBER _____ feet from east/west line of section _____
 FIELD _____ SECTION _____ TWP _____ RG _____

NUMBER OF ACRES ATTRIBUTABLE TO WELL _____ IS SECTION _____ REGULAR or _____ IRREGULAR
 QTR/QTR/QTR OF ACREAGE _____ - _____ - _____ IF SECTION IS IRREGULAR, LOCATE WELL FROM NEAREST CORNER BOUNDARY.

Section corner used: _____ NE _____ NW _____ SE _____ SW

PLAT

(Show location of the well and shade attributable acreage for prorated or spaced wells.)
 (Show footage to the nearest lease or unit boundary line.)

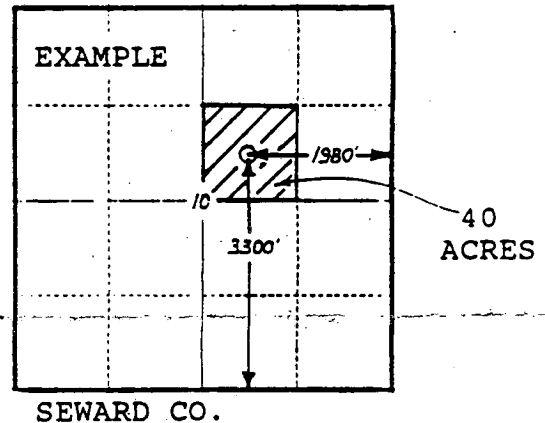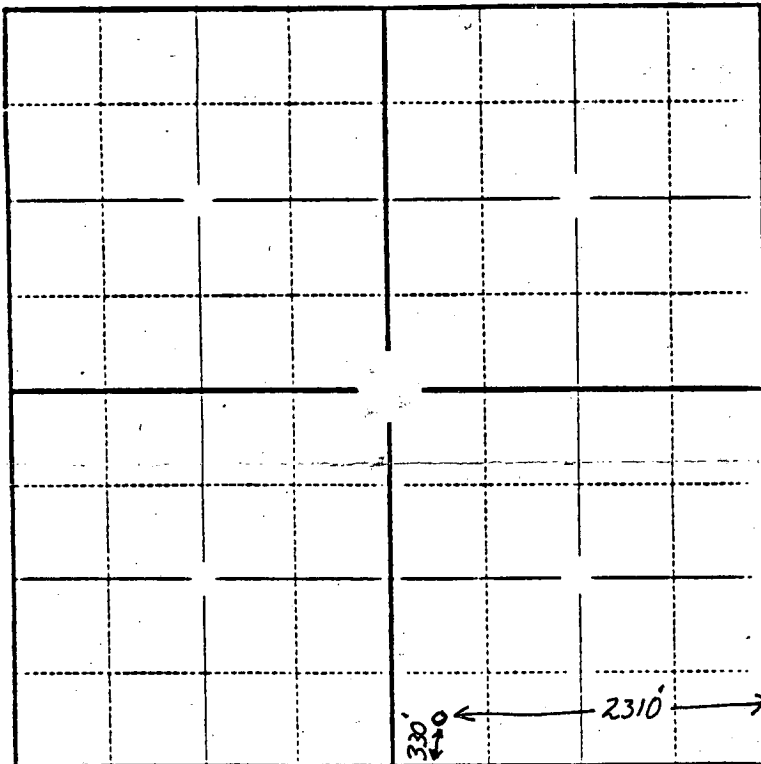

In plotting the proposed location of the well, you must show:

- 1) The manner in which you are using the depicted plat by identifying section lines, i.e. 1 section; 1 section with 8 surrounding sections, 4 sections, etc.;
- 2) the distance of the proposed drilling location from the section's south/north and east/west; and
- 3) the distance to the nearest lease or unit boundary line.