


STATE OF KANSAS
STATE CORPORATION COMMISSION

WELL PLUGGING RECORD

Give All Information Completely
Make Required Affidavit
Mail or Deliver Report to:
Conservation Division
State Corporation Commission
800 Bitting Building
Wichita, Kansas

NORTH

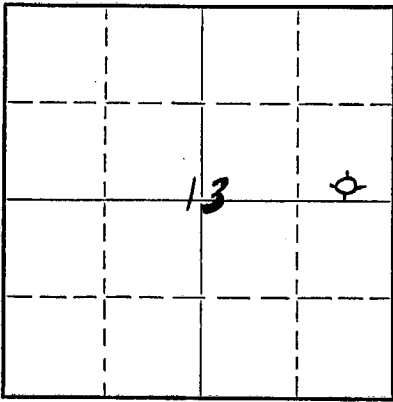

Locate well correctly on above
Section Plat

Sedgwick County. Sec. 13 Twp 26S Rge. 2 (E) (#)
Location as "NE/CNW 1/4 SW 1/4" or footage from lines Cen S/2 SE NE
Lease Owner John P. Gaty
Lease Name Petitjean Well No. 4
Office Address 11 Cypress Dr., Wichita, Kansas
Character of Well (completed as Oil, Gas or Dry Hole)
Date well completed Nov. 30 19 50
Application for plugging filed Feb. 1 19 51
Application for plugging approved Feb. 3 19 51
Plugging commenced Feb. 5 19 51
Plugging completed Feb. 5 19 51
Reason for abandonment of well or producing formation Dry Hole
If a producing well is abandoned, date of last production -- 19 --
Was permission obtained from the Conservation Division or its agents before plugging was commenced? Yes

Name of Conservation Agent who supervised plugging of this well Dwight C. Lilley
Producing formation Mississippi Depth to top 2818 Bottom -- Total Depth of Well 2865 Feet
Show depth and thickness of all water, oil and gas formations.

OIL, GAS OR WATER RECORDS

CASING RECORD

Formation	Content	From	To	Size	Put In	Pulled Out

Describe in detail the manner in which the well was plugged, indicating where the mud fluid was placed and the method or methods used in introducing it into the hole. If cement or other plugs were used, state the character of same and depth placed, from -- feet to -- feet for each plug set.

Calseal Plug and 3 sacks Cement on bottom
Mudded to 150!
15! rock bridge w/10 sacks Cement 150! to 135!
Mudded 135! to 30!
15! rock bridge 5 sacks Cement in Cellar


RECEIVED
STATE CORPORATION COMMISSION
2-10-51
FEB 10 1951
CONSERVATION DIVISION
Wichita, Kansas

(If additional description is necessary, use BACK of this sheet)

Correspondence regarding this well should be addressed to John P. Gaty
Address 11 Cypress Drive
Wichita, Kansas

STATE OF _____, COUNTY OF _____, ss.
_____, (employee of owner) or (owner or operator) of the above-described well,
being first duly sworn on oath, says: That I have knowledge of the facts, statements, and matters herein contained and the log of the above-described well as filed and that the same are true and correct. So help me God.

(Signature) + *Wm Vallorich*

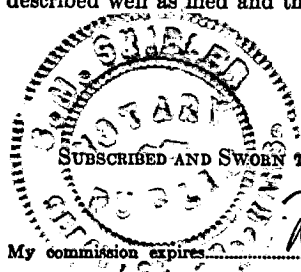

SUBSCRIBED AND SWORN to before me this 9 day of February, 19 51
D. M. Hedler
Notary Public.

PLUGGING
FILE SEC-13 T-2 R-2E
BOOK PAGE 59 LINE 28

Well Log - Petition #4

OPERATOR: Mr. J. P. Gaty
c/o Beech Aircraft Corp.
Wichita, Kansas

Location: C 2/2 38 NE
Section 13-26-2
Sedgewick County, Kans.

CONTRACTOR: Morrison Drilling Company, Inc.
P. O. Drawer 712
El Dorado, Kansas

PRODUCTION: _____

Farm: Petition Well No. 4

Date Commenced: November 23, 1950

Date Completed: November 30, 1950

Total Depth: 2850' - Rotary

<u>From</u>	<u>To</u>	<u>Formation</u>	<u>From</u>	<u>To</u>	<u>Formation</u>
51	85	Plug & Cement	2441	2548	Lime
85	230	Lime & Shale	2548	2595	Shale
230	235	Lime & Shells	2595	2818	Shale & Shells
235	242	Red Bed	2818	2837	Lime- Mississippi
242	400	Lime & Shells	2837	2850	Lime
400	405	Lime & Shale	2850		Total Depth.
405	410	Shale			
410	415	Red Bed			
415	445	Lime-broken			
445	450	Red Bed			
450	500	Lime & Shale			
500	515	Red Bed			
515	560	Lime & Shale			
660	665	Red Bed			
665	670	Lime			
670	810	Shale & Lime Shells			
810	840	Lime			
840	915	Shale & Shells			
915	923	Red Bed			
923	1115	Shale & Shells			
1115	1175	Shale & Lime Brks.			
1175	1655	Shale & Shells			
1655	1721	Lime			
1721	2015	Shale w/lime brks.			
2015	2133	Shale & Shells			
2133	2154	Lime			
2154	2175	Shale			
2175	2250	Lime & Shale			
2250	2310	Broken Lime			
2310	2360	Shale & Shells			
2360	2387	Shale			
2387	2441	Lime - K.C.			

Cable Tool Log

2850 - 2870 $\frac{1}{2}$ Dolomite
2870 $\frac{1}{2}$ - 2865 (S.M.)
2865 T.O.

I hereby certify that the foregoing is a true and correct copy of the Well Log for the Petition #4 well drilled for Mr. J. P. Gaty and completed November 30, 1950.

MORRISON DRILLING COMPANY, INC.

(Signed) C. W. Wilson
C. W. Wilson-Secretary-Treasurer

STATE OF KANSAS)
) ss.
COUNTY OF BUTLER)

SUBSCRIBED AND SWORN TO, Before the undersigned, a Notary Public, in and for the County and State aforesaid this 27th day of December 1950.

FILED
DEC 27 1950
59
28

(Signed) Wm. Biles
Notary Public

My Commission Expires January 10, 1951.