


STATE OF KANSAS
STATE CORPORATION COMMISSION

Give All Information Completely
Make Required Affidavit
Mail or Deliver Report to:
Conservation Division
State Corporation Commission
211 No. Broadway
Wichita, Kansas

WELL PLUGGING RECORD

T - 26 NORTH R - 2E

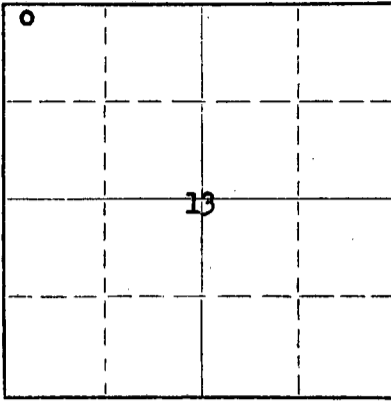

Locate well correctly on above
Section Plat

Sedgwick County. Sec. 13 Twp. 26 Rge. 2E (E) X (W)
Location as "NE/CNW/SW" or footage from lines NW - NW - NW
Lease Owner Frank J. Black
Lease Name Stollei Well No. 1
Office Address Box 150, McPherson, Kansas
Character of Well (completed as Oil, Gas or Dry Hole) Oil
Date well completed Jan. 18 19 57
Application for plugging filed Nov. 23 19 59
Application for plugging approved Nov. 24 19 59
Plugging commenced Nov. 30 19 59
Plugging completed Dec. 2 19 59
Reason for abandonment of well or producing formation Unprofitable

If a producing well is abandoned, date of last production _____ 19 ____
Was permission obtained from the Conservation Division or its agents before plugging was commenced? Yes

Name of Conservation Agent who supervised plugging of this well Lee Guthrie
Producing formation _____ Depth to top _____ Bottom _____ Total Depth of Well 2880 Feet
Show depth and thickness of all water, oil and gas formations.

OIL, GAS OR WATER RECORDS

CASING RECORD

FORMATION	CONTENT	FROM	TO	SIZE	PUT IN	PULLED OUT
				8-5/8"	130'	None
				5-1/2"	2873'	2519'

Describe in detail the manner in which the well was plugged, indicating where the mud fluid was placed and the method or methods used in introducing it into the hole. If cement or other plugs were used, state the character of same and depth placed, from _____ feet to _____ feet for each plug set.

Fill hole with chat to 2860' & cement to 2825' - 5 sks.
Fill hole with mud to 220' & rock to 200' & run cem. - 25 sks.
Fill hole with mud to 35' & rock to 25' & cap with cement - 10 sks.
Work started 11-30-59; Work completed 12-2-59

RECEIVED
STATE CORPORATION COMMISSION
12-9-59
DEC 9 1959
CONSERVATION DIVISION
Wichita, Kansas

(If additional description is necessary, use BACK of this sheet)
Name of Plugging Contractor Morgan Well Plugging Service License # 43
Address 102 West Eighteenth, Hutchinson, Kansas

STATE OF KANSAS, COUNTY OF MCPHERSON, ss.
Frank J. Black (owner or operator) of the above-described well, being first duly sworn on oath, says: That I have knowledge of the facts, statements, and matters herein contained and the log of the above-described well as filed and that the same are true and correct. So help me God.

(Signature) [Signature]
(Address) _____

Subscribed and Sworn to before me this 8th day of December, 19 59



July 16, 1963

Jerry Peltzman
JERRY PELTZMAN
Notary Public.

WELL LOG BUREAU—KANSAS GEOLOGICAL SOCIETY
503 East Murdock, Wichita, Kansas


COPY

Company- BEDELL-CATT DRILLING CO., INC.
Farm- Stollei No. 1

SEC. 13 T. 26 R. 2E
NW NW NW

Total Depth. 2880
Comm. 1-10-57 Comp. 1-18-57
Shot or Treated.
Contractor. Bedell-Catt Drlg Co., Inc.
Issued. 2-23-57

County Sedgwick
KANSAS

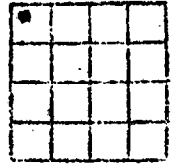

CASING:
8 5/8" 130' cem w/130 sx.
5 1/2" 2873' cem w/ 50 sx.

Elevation. 1375

Production. 25 BOPD

Figures indicate Bottom of Formations

surface hole	130
lime	135
shale, lime	2209
lime	2564
shale, lime	2847
lime cherty	2880
Total Depth	

Tops: Scout	
Kansas City	2401
Conglomerate	2840
Mississippian	2847

RECEIVED
STATE CORPORATION COMMISSION

DEC 9 1959

CONSERVATION DIVISION
Wichita, Kansas