


STATE OF KANSAS
STATE CORPORATION COMMISSION

Give All Information Completely
Make Required Affidavit
Mail or Deliver Report to:
Conservation Division
State Corporation Commission
211 No. Broadway
Wichita, Kansas

WELL PLUGGING RECORD

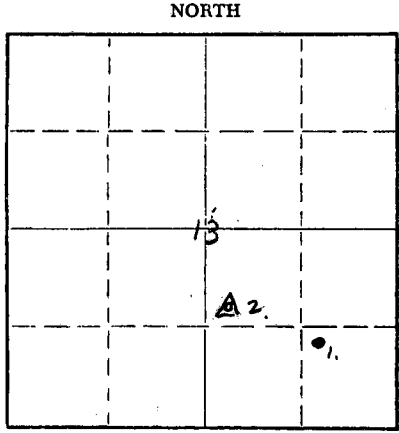

Locate well correctly on above
Section Plat

Sedgwick County. Sec. 13 Twp. 26 S Rge. 2 (E) (W)
Location as "NE/CNW/SW" or footage from lines SW-NW-SE
Lease Owner John P. Gaty
Lease Name Wheeler Well No. 2
Office Address 11 Cypress Dr., Wichita 6, Kansas
Character of Well (completed as Oil, Gas or Dry Hole) ~~Salt Water Disposal~~ DH
Date well completed May 3, 19 60
Application for plugging filed November 2, 19 60
Application for plugging approved November 3, 19 60
Plugging commenced November 12, 19 60
Plugging completed November 17, 19 60
Reason for abandonment of well or producing formation

If a producing well is abandoned, date of last production 19
Was permission obtained from the Conservation Division or its agents before plugging was commenced? Yes

Name of Conservation Agent who supervised plugging of this well Lee N. Guthrie
Producing formation Depth to top Bottom Total Depth of Well 3245 Feet
Show depth and thickness of all water, oil and gas formations.

OIL, GAS OR WATER RECORDS

CASING RECORD

FORMATION	CONTENT	FROM	TO	SIZE	PUT IN	PULLED OUT

Describe in detail the manner in which the well was plugged, indicating where the mud fluid was placed and the method or methods used in introducing it into the hole. If cement or other plugs were used, state the character of same and depth placed, from feet to feet for each plug set.

Rock and cement from 3245' to 3190'
Mud to 200'
20' rock bridge and 25 sacks cement at 200'
Mud to 35'
5' Rock bridge and cement to surface

RECEIVED
STATE CORPORATION COMMISSION
12-13-60
DEC 13 1960
CONSERVATION DIVISION
Wichita, Kansas


(If additional description is necessary, use BACK of this sheet)
Name of Plugging Contractor John P. Gaty
Address 11 Cypress Drive, Wichita 6, Kansas

STATE OF Kansas, COUNTY OF Sedgwick, ss.
Earl Wentworth (employee of owner) or (owner or operator) of the above-described well, being first duly sworn on oath, says: That I have knowledge of the facts, statements, and matters herein contained and the log of the above-described well as filed and that the same are true and correct. So help me God.

(Signature) Earl Wentworth
734 Pippin Court, Wichita, Kansas (Address)

SUBSCRIBED AND SWORN to before me this 1st day of December, 19 60
December 12, 1963
My commission expires

J. Arnold Dowd Notary Public.

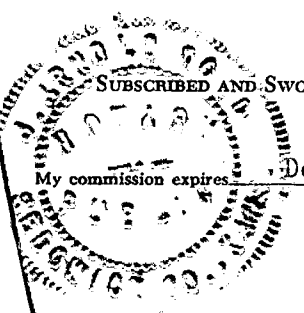

R
J. P. Gaty, Wheeler # 2

SW NW SE Section 13-26S-2E
Sedgwick County, Kansas

Commenced 4-23-60
Completed 5-1-60
Casing 105 - 8 5/8" csg. cmt. with 90 sx.

DRILLERS LOG

0 - 105	Shale and Lime
0 - 470	Lime and Shale
470 - 745	Shale and Lime
745 - 1100	Shale and Lime
1100 - 1460	Shale and Lime
1460 - 1710	Shale and Lime
1710 - 1910	Lime and Shale
1910 - 2119	Lime and Shale
2119 - 2315	Shale and Lime
2315 - 2475	Lime and Shale
2475 - 2590	Lime
2590 - 2730	Lime and Shale
2730 - 2838	Lime and Shale
2838 - 2915	Miss and Lime
2915 - 2969	Miss
2969 - 3010	Miss
3010 - 3048	Lime
3048 - 3083	Miss and Lime
3083 - 3115	Lime
3115 - 3185	Lime and Shale
3185 - 3245	Shale and Lime
3245 -	T. D.

I, the undersigned, being duly sworn on oath, state that the above Drillers Log is true and correct to the best of my knowledge and belief and according to the records of this office.

J. S. SUTTON & SONS DRILLING COMPANY

Signed: J. S. Sutton

Subscribed and sworn to before me this 24th day of May 1960.

Signed: Henry D. Ficken
Notary Public

My Commission expires February 27, 1961

COPY

SIGNED

DEC. 1960

CO. 107