




WELL PLUGGING RECORD

Give All Information Completely
Make Required Affidavit
Mail or Deliver Report to:
Conservation Division
State Corporation Commission
212 North Market, Insurance Bldg.
Wichita, Kansas

NORTH

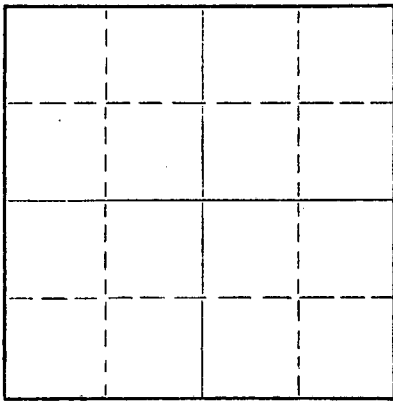

Locate well correctly on above
Section Plat

Sedgwick County, Sec. 13 Twp. 26S Rge. 2 (E) X (W)
Location as "NE/CNW/SW" or footage from lines NW SW NW
Lease Owner Raymond Oil Company, Inc.
Lease Name Stollei "B" Well No. #1
Office Address 410 Fourth National Bank Bldg., Wichita, Kansas
Character of Well (completed as Oil, Gas or Dry Hole) _____
Date well completed _____ 19____
Application for plugging filed _____ 19____
Application for plugging approved 2-9-62 19____
Plugging commenced 2-16-62 19____
Plugging completed 2-19-62 19____
Reason for abandonment of well or producing formation _____

If a producing well is abandoned, date of last production _____ 19____
Was permission obtained from the Conservation Division or its agents before plugging was commenced? Yes

Name of Conservation Agent who supervised plugging of this well Lee Guthrie
Producing formation _____ Depth to top _____ Bottom _____ Total Depth of Well 2885' Feet
Show depth and thickness of all water, oil and gas formations.

OIL, GAS OR WATER RECORDS

CASING RECORD

FORMATION	CONTENT	FROM	TO	SIZE	PUT IN	PULLED OUT

Describe in detail the manner in which the well was plugged, indicating where the mud fluid was placed and the method or methods used in introducing it into the hole. If cement or other plugs were used, state the character of same and depth placed, from _____ feet to _____ feet for each plug set.

Dumped 5 sacks cement on bottom with dump baler.
Sat rock bridge at 160' dump 15 sacks cement.
Mud 30' - sat rock bridge with 5 sacks cement for top cap.

RECEIVED
STATE CORPORATION COMMISSION
FEB 21 1962
2-21-62
CONSERVATION DIVISION
Wichita, Kansas


(If additional description is necessary, use BACK of this sheet)
Name of Plugging Contractor Southwest Casing Pulling Co., Inc.
Address Box 364, Great Bend, Kansas

STATE OF Kansas, COUNTY OF Barton, ss.
Southwest Casing Pulling Co., Inc. (employee of owner) or (owner or operator) of the above-described well, being first duly sworn on oath, says: That I have knowledge of the facts, statements, and matters herein contained and the log of the above-described well as filed and that the same are true and correct. So help me God.

(Signature) W. C. Spencer Sec. - Treas.
Box 364, Great Bend, Kansas
(Address)

SUBSCRIBED AND SWORN TO before me this 20 day of February, 1962

My commission expires 24 October 1964
Sidney D. Miller
Notary Public.

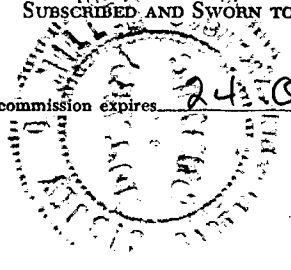

RAYMOND #1 STOLLEI "B"
 NW SW NW, 13-26S-2E
 Sedgwick County, Kansas

Contractor: Raymond Oil Company, Inc.

Comm: 2-13-57
Comp: 2-21-57

Elev: 1362 KB
1379 DF
1377 GL

Casing: 8-5/8" @ 103'
5-1/2" @ 2882'

Cement: 125 sz., 2 CC
50 sz.

Figures Indicate Bottom of Formation

<u>Formation</u>	<u>Depth</u>
Shale & Lime	103
Shale & Lime Shells	250
Lime	485
Lime & Shale	615
Lime	680
Shale & Lime	770
Shale & Shells	1360
Lime & Shale	2415
Lime	2575
Shale & Lime	2870
Lime & Chert	2885

Tops:

Lansing	2198
Kansas City	2405
Base Kansas City	2568
Conglomerate	2842
Mississippian	2849
Mississippian Chert	2882
Rotary Total Depth	2885

RECEIVED
 STATE CORPORATION COMMISSION

DEC 17 1953

CONSERVATION DIVISION
 Wichita, Kansas

STATE OF KANSAS)
) ss
 COUNTY OF SEDGWICK)

I hereby certify that the above information is true and correct to the best of my knowledge.

Lloyd M. Greenstreet
 Lloyd M. Greenstreet

Subscribed and sworn to before me this 25th day of February 1957.

G. ...
 Notary Public

My Commission Expires: 12/3/60

