

STATE OF KANSAS
STATE CORPORATION COMMISSION


WELL PLUGGING RECORD

Give All Information Completely
Make Required Affidavit
Mail or Deliver Report to:
Conservation Division
State Corporation Commission
800 Bittig Building
Wichita, Kansas

Sedgwick County, Sec. 13 Twp. 26S Rge. 2 (E) (W)

Location as "NE/CNW/SW" or footage from lines NW/2 NE/4 NE/4
Lease Owner John P. Gaty
Lease Name Petitjean Well No. 1
Office Address 11 Cypress Dr., Wichita, Kansas
Character of Well (completed as Oil, Gas or Dry Hole) Salt Water Disposal
Date well completed May 7, 19 49
Application for plugging filed January 20, 19 55
Application for plugging approved January 24, 19 55
Plugging commenced January 24, 19 55
Plugging completed January 24, 19 55
Reason for abandonment of well or producing formation

NORTH

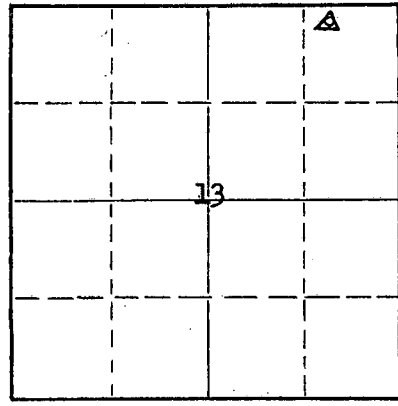

Locate well correctly on above Section Plat

If a producing well is abandoned, date of last production 19
Was permission obtained from the Conservation Division or its agents before plugging was commenced? Yes

Name of Conservation Agent who supervised plugging of this well Ruel Durkee
Producing formation Depth to top Bottom Total Depth of Well 3308 Feet
Show depth and thickness of all water, oil and gas formations.

OIL, GAS OR WATER RECORDS

CASING RECORD

FORMATION	CONTENT	FROM	TO	SIZE	PUT IN	PULLED OUT

Describe in detail the manner in which the well was plugged, indicating where the mud fluid was placed and the method or methods used in introducing it into the hole. If cement or other plugs were used, state the character of same and depth placed, from feet to feet for each plug set.

Put three yards of heavy mud in bottom
20' rock bridge with 20 sacks cement at 150'
Mudded to surface
Capped with 5 sacks cement

RECEIVED
STATE CORPORATION COMMISSION
FEB 2 1955
2-3-55
CONSERVATION DIVISION
KANSAS

(If additional description is necessary, use BACK of this sheet)
Name of Plugging Contractor John P. Gaty
Address 11 Cypress Dr., Wichita, Kansas

STATE OF Kansas, COUNTY OF Sedgwick, ss.
Earl Wentworth (employee of owner) of the above-described well, being first duly sworn on oath, says: That I have knowledge of the facts, statements, and matters herein contained and the log of the above-described well as filed and that the same are true and correct. So help me God.

(Signature) + Earl Wentworth
734 Pippin Cour, Wichita, Kansas (Address)

SUBSCRIBED AND SWORN TO before me this 2nd day of February, 19 55
My commission expires December 12, 1955
Notary Public.

PLUGGING
FILE SEC 13 T 26 R 25
BOOK PAGE 92 LINE 26

WELL LOG - PETITJEAN #1

Company: John P. Gaty
c/o Beech Aircraft Corp.
Wichita, Kansas

Location: 990' West 330' South from
the NE/C of NE/4
Section 13, 26-2E
Sedgwick County, Kansas

Contractor: Morrison Drilling Co., Inc.
Drawer 712
El Dorado, Kansas

Production: _____

Farm: Petitjean Well No. 1

Date Commenced: April 30, 1949
Date Completed: May 7, 1949

Total Depth: 2837'

<u>From</u>	<u>To</u>	<u>Formation</u>
35	75	Plug and Cement
75	80	Cement
80	240	Shale and Shells
240	510	Lime
510	550	Shale and Shells
550	630	Shale and Lime
630	845	Sandy Lime and Shale
845	1130	Shale
1130	1165	Lime
1165	1210	Shale and Lime
1210	1300	Shale and Shells
1300	1340	Lime - sandy
1340	1420	Shale and Shells
1420	1615	Lime and Shale streaks
1615	1815	Lime
1815	2015	Lime and Shale
2015	2265	Lime
2265	2290	Lime and Shale
2290	2318	Shale and shells
2318	2357	Lime and Shale breaks
2357	2390	K. C. Lime
2390	2480	Lime
2480	2675	Lime and Shale
2675	2705	Lime
2705	2811	Lime and Shale
2811	2815	Shale
2815	2830	Chat
2830	2837	Dolomite
2837		T.D.

RECEIVED
FEB 10 1955
STATE OF KANSAS
CO. OF SEDGWICK

I hereby certify that the above is a true and correct copy of the Well Log for John P. Gaty's Well #1 Petitjean, completed May 7, 1949.

C. W. Wilson
C. W. Wilson
Secretary-Treasurer

STATE OF KANSAS)
) ss.
COUNTY OF BUTLER)

SUBSCRIBED AND SWORN TO, Before the undersigned, a Notary Public in and for the County and State aforesaid this 9th day of May, 1949.



Notary Public
Notary Public

Cable Tool Log

Top of Viold Lime 3175'
Top of Simpson Sand 3225'
Top of Arbuckle Lime 3308'
Hole dry and abandoned.

PLUGGING
FMS SEC 13 26-2E
COST PAGE 19 26