


STATE OF KANSAS
STATE CORPORATION COMMISSION

WELL PLUGGING RECORD

Give All Information Completely
Make Required Affidavit
Mail or Deliver Report to:
Conservation Division
State Corporation Commission
800 Biting Building
Wichita, Kansas

Sedgwick County. Sec. **17** Twp. **26** Rge. **2** (E) (W)
Location as "NE/CNW/SW" or footage from lines **Ne Sw Ne**

Lease Owner **J.P. Gatey**
Lease Name **Joe Tjaeden** Well No. **1**
Office Address **11 Cypress Drive Wichita, Kansas**
Character of Well (completed as Oil, Gas or Dry Hole) **Oil**
Date well completed **November 22,** 19 **50**
Application for plugging filed **June 10,** 19 **54**
Application for plugging approved **June 11,** 19 **54**
Plugging commenced **June 16, 1954** 19
Plugging completed **June 19, 1954** 19
Reason for abandonment of well or producing formation _____

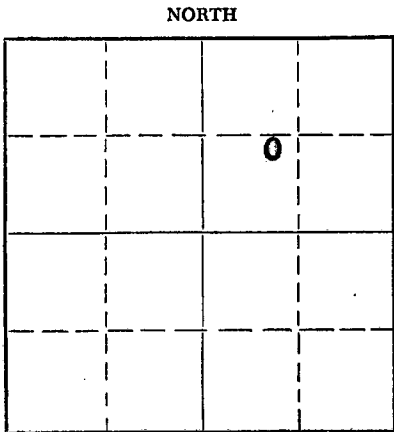

Locate well correctly on above
Section Plat

If a producing well is abandoned, date of last production _____ 19____
Was permission obtained from the Conservation Division or its agents before plugging was commenced? **yes**

Name of Conservation Agent who supervised plugging of this well **Ruel Durkee**
Producing formation **Burgess Sand** Depth to top **2942** Bottom **2947** Total Depth of Well **2947** Feet
Show depth and thickness of all water, oil and gas formations.

OIL, GAS OR WATER RECORDS

CASING RECORD

FORMATION	CONTENT	FROM	TO	SIZE	PUT IN	PULLED OUT
Burgess Sand	Oil & Water	2942	2947'	5 1/2"	2942'	2700.55'
				8 5/8"	198'	None

Describe in detail the manner in which the well was plugged, indicating where the mud fluid was placed and the method or methods used in introducing it into the hole. If cement or other plugs were used, state the character of same and depth placed, from _____ feet to _____ feet for each plug set.

The above well was filled with gravel from 2947' to 2930' then filled with cement from 2930' to 2870' then mud to 200' then rock to 190' then cement to 145' (15 Sacks of Cement) then mud to 24' then cement to top of surface pipe at 18'

Name of Plugging Contractor **F.W. Kellum (33)**
Address **1218 Hackney St. Winfield, Kansas**

STATE OF Kansas COUNTY OF Sedgwick, ss.
J.P. Gatey (employee of owner) or (owner or operator) of the above-described well, being first duly sworn on oath, says: That I have knowledge of the facts, statements, and matters herein contained and the log of the above-described well as filed and that the same are true and correct. So help me God.

(Signature) J.P. Gatey
(Address) 11 Cypress Drive Wichita, Kansas

SUBSCRIBED AND SWORN to before me this 21st day of June, 1954

My commission expires December 17, 1955 Notary Public.

24-7368-S 3-53-20M

PLUGGING
FILED 17 26 25
BOOK 40 LINE 36

RECEIVED
STATE CORPORATION COMMISSION
JUN 23 1954
6-23-54
CONSERVATION DIVISION
Wichita, Kansas

WELL LOG - Joe Tjaden #1

OPERATOR; Mr. J. P. Gaty
c/o Beech Aircraft Corp.
Wichita, Kansas

LOCATION: NE SW NE
Section 17-26-2E
Sedgwick County, Kans.

CONTRACTOR: Morrison Drilling Company, Inc.
P. O. Drawer 712
El Dorado, Kansas

PRODUCTION: _____

Farm: Joe Tjaden Well No. 1

Date Commenced: November 15, 1950
Date Completed: November 22, 1950

Total Depth: 2947 feet - Rotary

From	To	Formation
60	103	Plug and Cement
103	125	Broken Lime
125	280	Lime & Shells
280	295	Lime, shale & Shells
295	420	Lime & Shale brks.
420	625	Lime & Shale
625	630	Red Bed
630	650	Shale & Shells
650	795	Shale & lime brks.
795	950	Lime & Shale brks.
950	1030	Shale
1030	1035	Red Bed
1035	1285	Shale & Shells
1285	1340	Lime & Shale
1340	1477	Shale & Shells
1477	1520	Lime
1520	1605	Shale & Shells
1605	1640	Lime
1640	1700	Shale & Shells
1700	1720	Lime
1720	1785	Lime & Shale
1785	1828	Lime & Shale Brks.
1828	2090	Shale & Shells
2090	2307	Shale w/lime strks.
2307	2370	Lime & Shale brks.
2370	2511	Shale & Shells
2511	2664	Lime
2664	2947	Shale & Shells
2947		Total Depth

CABLE TOOL LOG

2947-47½ Sand
S/ H.F.O.

I hereby certify that the foregoing is a true and correct copy of the Well Log for the Tjaden #1 well drilled for Mr. J. P. Gaty and completed November 22, 1950.


RECEIVED
REGISTRATION COMMISSION
JUN 11 1954
REGISTRATION DIVISION
Wichita, Kansas

MORRISON DRILLING COMPANY, INC.

S/ C. W. Wilson
C. W. Wilson
Secretary-Treasurer

STATE OF KANSAS)
COUNTY OF BUTLER) ss.

SUBSCRIBED AND SWORN TO, Before the undersigned, a Notary Public, in and for the County and State aforesaid this 24th day of November, 1950.

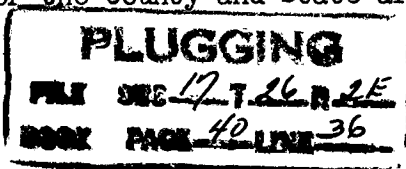

S/ Wm. Biles
Notary Public

My Commission Expires January 10, 1951.