


WELL PLUGGING RECORD

Give All Information Completely  
Make Required Affidavit  
Mail or Deliver Report to:  
Conservation Division  
State Corporation Commission  
800 Biting Building  
Wichita, Kansas

NORTH

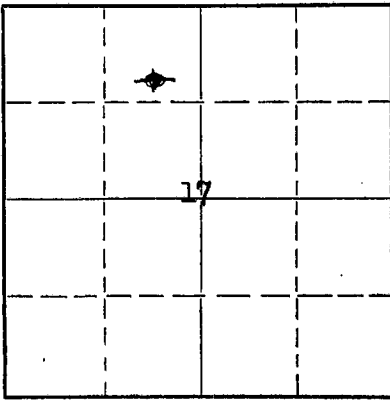

Locate well correctly on above Section Plat

Sedgwick County. Sec. 17 Twp. 26 Rge. 2 (E) (W)  
Location as "NE/CNW/SW" or footage from lines Cen. S/2 NE/4 NW/4  
Lease Owner John P. Gaty  
Lease Name Joe Tjaden B Well No. 1  
Office Address 11 Cypress Dr.  
Character of Well (completed as Oil, Gas or Dry Hole) Dry Hole  
Date well completed March 27, 19 56  
Application for plugging filed March 27, 19 56  
Application for plugging approved March 27, 19 56  
Plugging commenced March 28, 19 56  
Plugging completed March 31, 19 56  
Reason for abandonment of well or producing formation Dry Hole

If a producing well is abandoned, date of last production 19  
Was permission obtained from the Conservation Division or its agents before plugging was commenced? Yes

Name of Conservation Agent who supervised plugging of this well Ruel Durkee  
Producing formation \_\_\_\_\_ Depth to top \_\_\_\_\_ Bottom \_\_\_\_\_ Total Depth of Well 3020 Feet  
Show depth and thickness of all water, oil and gas formations.

OIL, GAS OR WATER RECORDS

CASING RECORD

FORMATION	CONTENT	FROM	TO	SIZE	PUT IN	PULLED OUT

Describe in detail the manner in which the well was plugged, indicating where the mud fluid was placed and the method or methods used in introducing it into the hole. If cement or other plugs were used, state the character of same and depth placed, from \_\_\_\_\_ feet to \_\_\_\_\_ feet for each plug set.


Plugged from 3020' to 2970' with sand and 6 sacks cement.  
Mudded from 2970' to 135'  
20 Sacks cement and rock bridge at 135'  
Mudded 135' to surface  
Capped with 5 sacks cement

(If additional description is necessary, use BACK of this sheet)

Name of Plugging Contractor John P. Gaty  
Address 11 Cypress Dr.

STATE OF Kansas COUNTY OF Sedgwick  
Earl Wentworth (employee of owner) of the above-described well, being first duly sworn on oath, says: That I have knowledge of the facts, statements, and matters herein contained and the log of the above-described well as filed and that the same are true and correct. So help me God.

(Signature) Earl Wentworth  
734 Pippin Court, Wichita, Kansas  
(Address)

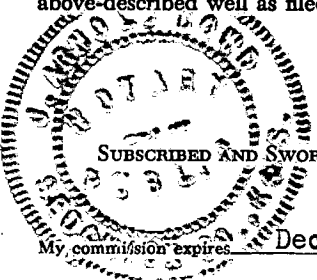

SUBSCRIBED AND SWORN TO before me this 6th day of April, 19 56  
J. Arnold Dowd Notary Public.

24-7366-5 3-53-20M

**PLUGGING**  
FILE SEC 17 T 26 R 2E  
BOOK PAGE 48 LINE 42

APR 11 1956  
Wichita, Kansas

DRILLERS' LOG  
S. NE NW Sec. 17-26-2E  
Sedgwick County, Kansas

OPERATOR: John P. Gaty  
CONTRACTOR: Mallonee Drilling Company, Inc.  
WELL: Joe Tjaden "B" #1

COMMENCED: 3/13/56  
COMPLETED: 3/21/56

<u>From</u>	<u>To</u>	<u>Description</u>	<u>Remarks</u>
0	40	Surface soil and shale	
40	75	Shale	
75	81	Lime	81' 12" hole. 8 5/8" casing set at 79' with 80 sks. common and 1% calcium chloride. Cement circulated.
81	175	Shale and sand	
175	275	Lime and shale	
275	345	Shale and shells	
345	695	Shale and lime	
695	830	Lime with shale breaks	
830	995	Lime	
995	1045	Shale and lime	
1045	1265	Shale and shells	
1265	1650	Lime and shale	
1650	1865	Shale and shells	
1865	2355	Lime	
2355	2550	Lime and shale	
2550	2984	Lime	
2984		Total depth of hole	96 fts. 5 1/2" casing set at 2983 1/2 with 20 sks. cement.

I certify that to the best of my knowledge and belief the above represents a true and accurate Drillers' Log of the captioned well.

J. W. Mallonee  
F. W. Mallonee

State of Kansas )  
County of Sedgwick )

Subscribed and sworn to before me this 26th day of March, 1956.

R. E. Mallonee  
R. E. Mallonee, Notary Public

My commission expires: March 7, 1957

**PLUGGING**  
FILE SEC 17 T 26 R 2 E  
BOOK PAGE 48 LINE 42