


WELL PLUGGING RECORD

Give All Information Completely  
Make Required Affidavit  
Mail or Deliver Report to:  
Conservation Division  
State Corporation Commission  
800 Bitting Building  
Wichita, Kansas

NORTH

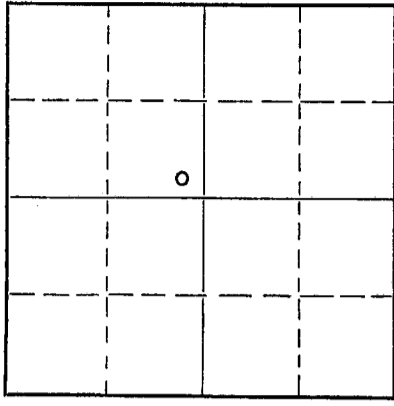

Locate well correctly on above Section Flat

Sedgwick County. Sec. 17 Twp. 26S Rge. 2E (E) (W)  
Location as "NE/CNW $\frac{1}{4}$ /SW $\frac{1}{4}$ " or footage from lines SE SE NW  
Lease Owner Charles Lamer Carlock  
Lease Name Tjaden Well No. 1  
Office Address 102 Insurance Bldg., Wichita, Kansas  
Character of Well (completed as Oil, Gas or Dry Hole) Dry Hole  
Date well completed July 23, 1950 19  
Application for plugging filed July 25, 1950 (verbal) 19  
Application for plugging approved July 25, 1950 19  
Plugging commenced July 25, 1950 19  
Plugging completed July 27, 1950 19  
Reason for abandonment of well or producing formation Dry Hole

If a producing well is abandoned, date of last production 19  
Was permission obtained from the Conservation Division or its agents before plugging was commenced? Yes

Name of Conservation Agent who supervised plugging of this well D. C. Lilley  
Producing formation Depth to top Bottom Total Depth of Well 2974 Feet  
Show depth and thickness of all water, oil and gas formations.

OIL, GAS OR WATER RECORDS

CASING RECORD

Formation	Content	From	To	Size	Put In	Pulled Out
				125'	8 5/8"	none
				2951'	5"	2600

Describe in detail the manner in which the well was plugged, indicating where the mud fluid was placed and the method or methods used in introducing it into the hole. If cement or other plugs were used, state the character of same and depth placed, from feet to feet for each plug set.

Dumped 5 sacks of cement on bottom  
Filled with heavy mud to 125 feet of surface  
Set 10 foot rock bridge at 125 feet  
Dumped 15 sacks of cement  
Filled with mud to 15 feet  
Set 5 foot rock bridge and filled with cement to surface.

(If additional description is necessary, use BACK of this sheet)

Correspondence regarding this well should be addressed to Charles Lamer Carlock  
Address 102 Insurance Bldg., Wichita, Kansas

STATE OF KANSAS, COUNTY OF SEDGWICK, ss.  
(employee of owner) or (owner or operator) of the above-described well, being first duly sworn on oath, says: That I have knowledge of the facts, statements, and matters herein contained and the log of the above-described well as filed and that the same are true and correct. So help me God.

(Signature) Charles Lamer Carlock  
102 Ins. Bldg., Wichita  
(Address)

SUBSCRIBED AND SWORN to before me this 27<sup>th</sup> day of July, 1950  
My Commission Expires Jan. 31, 1953  
Seward P. Greider  
Notary Public.



PLUGGING  
FILE SEC 17 T 26 R 2E  
BOOK PAGE 18 LINE 27

RECEIVED

Conservation Div.  
7-27-50  
JUL 27 1950  
STATE CORPORATION COMMISSION

WELL LOG - TJADEN WELL NO. 1

OPERATOR: Mr. Charles Carlock  
102 Insurance Building  
Wichita, Kansas

LOCATION: SE/4 SE/4 NW/4  
Section 17-26S-2E  
Sedgwick County, Kansas

CONTRACTOR: Morrison Drilling Company, Inc.  
P. O. Drawer 712  
El Dorado, Kansas

PRODUCTION: \_\_\_\_\_

Farm: Joe Tjaden Well No. 1

Date Commenced: July 13, 1950

Date Completed: July 18, 1950


Total Depth: 2951 feet

<u>From</u>	<u>To</u>	<u>Formation</u>	
101	164	Shale & Shells	
164	215	Lime & Hard Shells	
215	245	Lime	
245	270	Shale & Shells	
270	315	Broken Lime	
315	390	Shale & Broken Lime	
390	395	Red Bed	
395	470	Broken Lime	
470	635	Lime & Shale Brks.	
635	645	Shale & Red Bed	
645	700	Lime & Shale	
700	990	Shale & Lime Strks.	
990	1050	Shale	
1050	1355	Shale & Shells	
1355	1380	Lime	
1380	1475	Shale & Shells	
1475	1520	Lime & Shale Brks.	
1520	1605	Shale & Shells	
1605	1645	Lime	
1645	1820	Shale & Lime Strks.	
1820	1840	Lime	
1840	1870	Shale	
1870	1895	Lime	
1895	2155	Shale & Shells	
2155	2190	Lime	
2190	2199	Shale	
2199	2204	Sand	
2204	2311	Shale w/lime strks.	
2311	2335	Lime w/shale strks.	
2335	2370	Lime	
2370	2506	Shale	
2506	2670	Lime	
2670	2723	Shale	
2723	2804	Shale & Shells	
2804	2850	Broken Lime	
2850	2951	Shale & Shells	
2951		Total Depth	

	<u>Tops from rotary bushing</u>	
	Top K. C. Lime	2506
	Top basal Penn unconformity	2935
	Top Burgess Sand Zone	2950

I hereby certify that the foregoing is a true and correct copy of the Well Log for the Joe Tjaden #1 Well drilled for Mr. Charles Carlock and completed July 18, 1950.

  
C. W. Wilson -Secretary-Treasurer

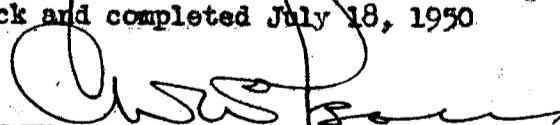STATE OF KANSAS )  
                          ) ss.  
COUNTY OF BUTLER )

SUBSCRIBED AND SWORN TO, Before the undersigned, a Notary Public, in and for the County and State aforesaid this 21st day of July, 1950.

My Commission Expires January 10, 1951.

  
Notary Public

17. 76. 76  
18. 76. 87