

KANSAS

WELL COMPLETION REPORT AND DRILLER'S LOG

S. 36 T. 27S R. 2 E W  
Loc. 100' W of C SE NE SE  
County Sedgwick

API No. 15 — 173 — 20,362 -00-00  
County Number

Operator  
Oil Tech Producers Corporation

Address  
P.O. Box 11606, 1149 So. Washington, Wichita, Ks. 67211


Well No. #1 Lease Name E.D. Sturdevant

Footage Location  
330 feet from (M) (S) line 430 feet from (E) (XX) line

Principal Contractor Triange Drilling Geologist Joe M. Baker

Spud Date 5/3/81 Date Completed 5/14/81 Total Depth 3,285 P.B.T.D.

Directional Deviation Oil and/or Gas Purchaser

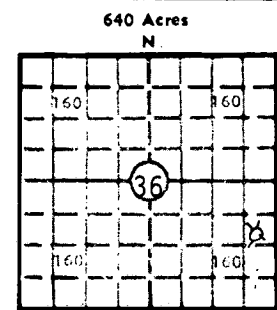

640 Acres  
Locate well correctly  
Elev.: Gr. 1,295  
DF 1,298 KB 1,300

CASING RECORD

Report of all strings set — surface, intermediate, production, etc.

Purpose of string	Size hole drilled	Size casing set (in O.D.)	Weight lbs/ft.	Setting depth	Type cement	Sacks	Type and percent additives
Surface	12 3/4	8 5/8		200	Common	70	
Production	7 7/8	4 1/2	9.5	3207	Common	100	

LINER RECORD

PERFORATION RECORD

Top, ft.	Bottom, ft.	Sacks cement	Shots per ft.	Size & type	Depth interval
			4		3,107 to 3,112

Size	Setting depth	Packer set at

ACID, FRACTURE, SHOT, CEMENT SQUEEZE RECORD

Amount and kind of material used	Depth interval treated
250 gallon 10% Mud Acid	3,107 to 3,112

INITIAL PRODUCTION

Date of first production	Producing method (flowing, pumping, gas lift, etc.)
RATE OF PRODUCTION PER 24 HOURS	Oil bbls. Gas bbls. Water MCF
Disposition of gas (vented, used on lease or sold)	Producing interval (s)

RECEIVED  
STATE CORPORATION COMMISSION  
NOV 4 1981  
CONSERVATION DIVISION  
Wichita, Kansas  
CFPB

INSTRUCTIONS: As provided in KCC Rule 82-2-125, within 90 days after completion of a well, one completed copy of this Drillers Log shall be transmitted to the State Geological Survey of Kansas, 4150 Monroe Street, Wichita, Kansas 67209. Copies of this form are available from the Conservation Division, State Corporation Commission, 245 No. Water, Wichita, Kansas 67202. Phone AC 316-522-2206. If confidential custody is desired, please note Rule 82-2-125. Drillers Logs will be on open file in the Oil and Gas Division, State Geological Survey of Kansas, Lawrence, Kansas 66044.



WELL LOG

Operator Oil Tech Producers Corporation  
 Comm \_\_\_\_\_ Comp \_\_\_\_\_  
 Shot \_\_\_\_\_ Qts. From \_\_\_\_\_ ft. To \_\_\_\_\_ ft.  
 Acidized \_\_\_\_\_ Gal. \_\_\_\_\_  
 Prod. Formation \_\_\_\_\_  
 Initial Prod. \_\_\_\_\_  
 Elevation \_\_\_\_\_

F.O. Sturdevant <sup>KCC</sup> ~~ZAP~~  
 Lease Sturdevant Well No. 1  
 Loc NE/4 of Sec 36 Twp 27S Rge 2E  
 County SE/4 Sedgwick State Kansas  
 Contractor Triangle Drlg & Expl Co., Inc  
 Casing Record

Size	Ft.	Pulled	Remarks
8 5/8	200	70 sks	cement
4 1/2	3203	100 sks	cement

FIGURES INDICATE BOTTOM OF FORMATION

0	-----	200	Surface
200	-----	219	Sandy Shale & Lime Stk
219	-----	754	Shale & Lime Stks
754	-----	1148	Shale & Lime Stks
1148	-----	1825	Shale & Lime
1825	-----	2077	Shale & Lime
2077	-----	2410	Shale & Lime
2410	-----	2492	K.C. Lime
2492	-----	2721	Lime & Shale
2721	-----	2821	Lime & Shale
2821	-----	2870	Shale
2870	-----	2993	Mississippi Lime
2993	-----	3043	Lime
3043	-----	3109	Lime
3109	-----	3118	Simpson Sand
3118	-----	3125	Simpson Sand
3125	-----	3200	Lime & Shale
3200	-----	3212	Lime & Shale
3212	-----	3285	Arbuckle RTD

RECEIVED  
 STATE CORPORATION COMMISSION  
 NOV 18 1981  
 CONSERVATION DIVISION  
 Wichita, Kansas