

15-16303759-0000

WELL PLUGGING RECORD


STATE OF KANSAS STATE CORPORATION COMMISSION

Give All Information Completely Make Required Affidavit Mail or Deliver Report to: Conservation Division State Corporation Commission 800 Bitting Building Wichita, Kansas

OR FORMATION PLUGGING RECORD

Strike out upper line when reporting plugging of formations.

Rooks County. Sec. 15 Twp. 9 Rge. 16 (W) Location as "NE1/4NW1/4SW1/4" or footage from lines In 660 North line and 330 West Lease Owner: O. F. Krueger Lease Name: Tatkenhorst Office Address: Natoma, Kansas Character of Well (completed as Oil, Gas or Dry Hole): Small producer Oil Date well completed: March 1941 Application for plugging filed: 8-2 Application for plugging approved: 8-4 Plugging commenced: 8-5 Plugging completed: 8-17 Reason for abandonment of well or producing formation: Depleted If a producing well is abandoned, date of last production: Jan Was permission obtained from the Conservation Division or its agents before plugging was commenced?: yes

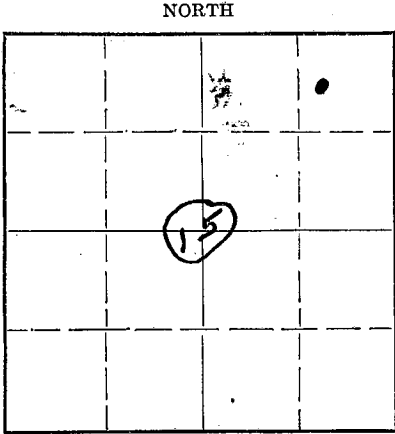

Locate well correctly on above Section Plat

Name of Conservation Agent who supervised plugging of this well: Mr. Petty Producing formation: K. C. Lime Depth to top: 3227 Bottom: 3425 Total Depth of Well: 3425 Feet Show depth and thickness of all water, oil and gas formations.

OIL, GAS OR WATER RECORDS

CASING RECORD

Table with 7 columns: Formation, Content, From, To, Size, Put In, Pulled Out. The table is currently empty.

Describe in detail the manner in which the well was plugged, indicating where the mud fluid was placed and the method or methods used in introducing it into the hole. If cement or other plugs were used, state the character of same and depth placed, from... feet to ... feet for each plug set.

Chat and cement 3425 to 3300 in 1941 to shut off water tried to produce not profitable Chat and cement 3300 to 3260 bottom of pipe perf. 3225 to 40 show not commercial Chat and cement 3260 to 3100 KK Shot pipe off 2560 filled well with mud set over nite balled oil & water down to 150 ft bridged hole on top of mud and ran 20 sax cement. Filled hole to 30 ft. ran 15 sax cement filled to top.

8/29/49

RECEIVED

AUG 29 1949

(If additional description is necessary, use BACK of this sheet.) Correspondence regarding this well should be addressed to: O. F. Krueger Address: Natoma, Kansas

STATE CORPORATION COMMISSION KANSAS

STATE OF Kansas COUNTY OF Osborne ss.


O. F. Krueger or (owner or operator) of the above-described well, being first duly sworn on oath, says: That I have knowledge of the facts, statements, and matters herein contained and the log of the above-described well as filed and that the same are true and correct. So help me God.

(Signature) O. F. Krueger

(Address) Natoma, Kansas, 1949 Notary Public: Huey Schloh

SUBSCRIBED AND SWORN to before me this 23rd day of August, 1949

My commission expires January 17, 1951

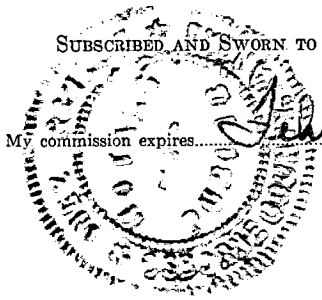

PLUGGING FILE SEC 15 T 9 R 16 W BOOK PAGE 109 W 32

15-163-03759-0040

Copy of Log on Tatkenhorst
D # 1 Well
Laton Pool, Rooks Co. Ks.

Elev. 2084

Drilled with Rotary tools
Casing set at 3260
Deepened W. Cable tools to 3425

Water at 3333

Plugged back to 3300

Later plugged back to bottom of
pipe 3260

Perf. 3225 to 3240 Show of oil. Acidized No increase

RECEIVED
Cons. Div.

AUG 29 1949

STATE CORPORATION
COMMISSION
KANSAS

8/29/49

PLUGGING			
FILE	SEC	T	R
	15	9	16w
BOOK	PAGE	LINE	
	109	32	