

Give All Information Completely
Make Required Affidavit
Mail or Deliver Report to:
Conservation Division
State Corporation Commission
212 No. Market
Wichita, Kansas

WELL PLUGGING RECORD

Osborne County, Sec. 35 Twp. 9S Rge. 15 (X) (W)

Location as "NE/CNW/SW" or footage from lines C E¹/₂ S¹/₂ SW¹/₄

Lease Owner Neven H. Veail

Lease Name Finnesy Well No. 2

Office Address 1401 McKinley, Great Bend, Kansas 67530

Character of Well (completed as Oil, Gas or Dry Hole) Dry Hole

Date well completed 2-24 1968

Application for plugging filed 2-24 1968

Application for plugging approved 2-24 1968


Plugging commenced 2-24 1968

Plugging completed 2-24 1968

Reason for abandonment of well or producing formation Dry Hole

If a producing well is abandoned, date of last production _____ 19____

Was permission obtained from the Conservation Division or its agents before plugging was commenced? Yes

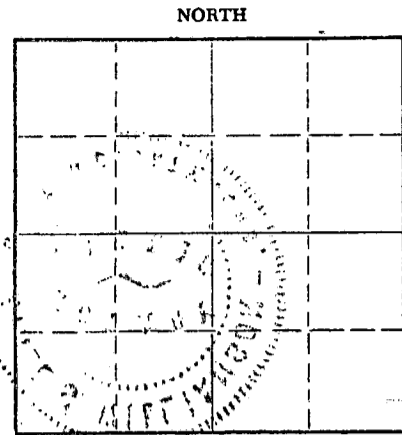

Locate well correctly on above Section Plat

Name of Conservation Agent who supervised plugging of this well Don Truan

Producing formation _____ Depth to top _____ Bottom _____ Total Depth of Well _____ Feet

Show depth and thickness of all water, oil and gas formations.

OIL, GAS OR WATER RECORDS

CASING RECORD

FORMATION	CONTENT	FROM	TO	SIZE	PUT IN	PULLED OUT
<p>RECEIVED STATE CORPORATION COMMISSION MAR 13 1968 CONSERVATION DIVISION Wichita, Kansas 03-13-1968</p>						

Describe in detail the manner in which the well was plugged, indicating where the mud fluid was placed and the method or methods used in introducing it into the hole. If cement or other plugs were used, state the character of same and depth placed, from _____ feet to _____ feet for each plug set.

3570 - 700 - Heavy rotary mud
700 - 240 - HB plug, 40 sacks cement
240 - 40 - Heavy rotary mud
40 - GL - HB plug, 10 sacks cement

Well plugged with Halliburton truck and equipment

(If additional description is necessary, use BACK of this sheet)

Name of Plugging Contractor Peel Brothers, Inc.
Address Box 359, Hoisington, Kansas 67544

STATE OF KANSAS, COUNTY OF Barton, ss.

Peel Brothers, Inc. (employee of owner) or Wendell C. Peel (owner or operator) of the above-described well, being first duly sworn on oath, says: That I have knowledge of the facts, statements, and matters herein contained and the log of the above-described well as filed and that the same are true and correct. So help me God. PEEL BROTHERS, INC.

(Signature) Wendell C. Peel
Wendell C. Peel, President

(Address)

SUBSCRIBED AND SWORN to before me this 27th day of February, 19 68

My commission expires 6-21-70

Ethel S. Williamson
Ethel S. Williamson Notary Public.

15-141-20004-00-00

DRILLER'S LOG

Well Owner: Neven H. Veail
Farm Name: Finnesy #2
Date Started: 2-14-68
Date Completed: 2-24-68
Total Depth: 3570'

Section 35-9S-15W
Osborne County, Kansas

Casing: 8-5/8" set at 247' cemented

Contractor: Peel Brothers, Inc.

Figures below show the bottoms of the formations:

Rock	0 - 50
Shale	915
Red Bed and Shells	1170
Anhydrite	1205
Shale and Shells	1236
Shale and Lime	2945
Lime and Shale	3140
Lime	3570
Total Depth	3570

RECEIVED
STATE CORPORATION COMMISSION
MAR 13 1968
CONSERVATION DIVISION
Wichita, Kansas

This is to certify that the above information is true and correct to the best of our knowledge.

PEEL BROTHERS, INC.

Wendell C. Peel

Wendell C. Peel
President

SUBSCRIBED AND SWORN to before me this 27th day of February, 1968.



Ethel S. Williamson

Ethel S. Williamson
Notary Public

My Commission expires 6-21-70