

STATE OF KANSAS
STATE CORPORATION COMMISSION

WELL PLUGGING RECORD

OR

FORMATION PLUGGING RECORD

Strike out upper line
when reporting plug-
ging off formations.

Give All Information Completely
Make Required Affidavit
Mail or Deliver Report to:
Conservation Division
State Corporation Commission
500 Bitting Building
Wichita, Kansas

Rooks County. Sec. 5 Twp. 9 Rge. 16 (E) (W)

Location as "NE $\frac{1}{4}$ NW $\frac{1}{4}$ SW $\frac{1}{4}$ " or footage from lines NE-NE-NE

Lease Owner Frank G. Wood

Lease Name Dunlap Well No. 1

Office Address Box 647, Great Bend, Kansas

Character of Well (completed as Oil, Gas or Dry Hole) Dry Hole

Date well completed June 28 19. 49

Application for plugging filed June 28 19. 49

Application for plugging approved June 28 19. 49


Plugging commenced June 28 19. 49

Plugging completed June 29 19. 49

Reason for abandonment of well or producing formation Dry

If a producing well is abandoned, date of last production 19.

Was permission obtained from the Conservation Division or its agents before plugging was commenced? Yes

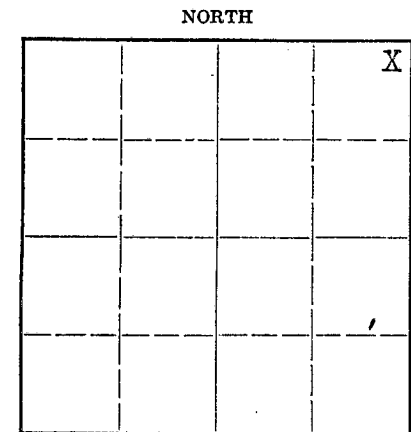

Locate well correctly on above
Section Plat

Name of Conservation Agent who supervised plugging of this well C. D. Slough

Producing formation Depth to top Bottom Total Depth of Well 3441 Feet

Show depth and thickness of all water, oil and gas formations.

OIL, GAS OR WATER RECORDS

CASING RECORD

Formation	Content	From	To	Size	Put In	Pulled Out
				8 5/8"	175'	None
				Cement Circulated		

Describe in detail the manner in which the well was plugged, indicating where the mud fluid was placed and the method or methods used in introducing it into the hold. If cement or other plugs were used, state the character of same and depth placed, from feet to feet for each plug set.

Hole filled with heavy mud to 175'. Set wood plug. Dumped 15 saxes cement on same. Mixed heavy.

Filled hole to 30', set plug at 30'. Mixed 10 saxes cement. Mixed heavy on same, Bringing cement to bottom of cellar.

RECEIVED

Conservation Div.

JUL - 9 1949

7-9-1949

STATE CORPORATION
COMMISSION
KANSAS

(If additional description is necessary, use BACK of this sheet)

Correspondence regarding this well should be addressed to Duke & Wood Drilling Company, Inc.

Address Box 647, Great Bend, Kansas

STATE OF _____, COUNTY OF _____, SS.


(employee of owner) or (owner or operator) of the above-described well, being first duly sworn on oath, says: That I have knowledge of the facts, statements, and matters herein contained and the log of the above-described well as filed and that the same are true and correct. So help me God.

(Signature) *James L. Dick*
Great Bend, Kansas
(Address)

SUBSCRIBED AND SWORN to before me this 7 day of July 1949

My commission expires May 9, 1951

21-6858-RS

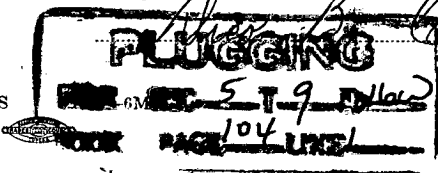

Notary Public.

Well Log
Dunlap No. 1
Rooks County, Kansas

No. of feet		No. of feet	
0 to 60	Surface Clay and Post Rock	1765 to 1880	Shale Anhydrite Shells
60 to 154	Shale	1880 to 1925	Shale and Anhydrite Shells
154 to 175	Blue Shale and Shells	1925 to 1950	Shale and Shells
175 to 380	Shale	1950 to 2015	Shale and Lime
380 to 410	Sand and Shale	2015 to 2095	Lime and Shale
410 to 650	Shale and Lime	2095 to 2145	Lime
650 to 725	Shale and Shells	2145 to 2250	Lime and Shale
725 to 760	Sand and Shale	2250 to 2290	Lime and Shale
760 to 815	Shale and Shells	2290 to 2350	Lime
815 to 895	Sand and Shells	2350 to 2403	Lime
895 to 950	Sand	2403 to 2440	Lime and Shale
950 to 1100	Red Bed and Shale	2440 to 2470	Lime and Shale
1100 to 1140	Red Bed and Shale	2470 to 2475	Sand
1140 to 1205	Red Bed, Shale, and Iron	2475 to 2515	Lime and Shale
1205 to 1255	Red Bed and Shale	2515 to 2630	Shale and Lime
1255 to 1290	Anhydrite	2630 to 2745	Shale and Lime
1290 to 1310	Red Bed and Shell	2745 to 2865	Shale and Lime
1310 to 1320	Anhydrite Shells	2865 to 2880	Shale and Lime
1320 to 1390	Red Bed and Iron Shale	2880 to 2905	Lime
1390 to 1435	Shale Shells	2905 to 2970	Lime
1435 to 1450	Iron and Shale	2970 to 3000	Lime
1450 to 1490	Shale and Red Bed Iron Streaks	3000 to 3094	Shale and Lime
1490 to 1570	Shale and Shells	3094 to 3200	Lime
1570 to 1700	Shale and Shells	3200 to 3170	Shale and Lime
1700 to 1765	Shale and Shells Anydrite Broken	3170 to 3425	Broken Lime
		3425 to 3441	Lime

PLUGGING
PAGE 104 LINE 1
3425 to 3441

7-9-1949

T. D.

Well Log

Top of Anhydrite	1255 Ft.
Top of Hebner Shale	3042 Ft.
Top of Kansas City	3094 Ft.
Top of Arbuckle	3425 Ft.

