


STATE OF KANSAS  
STATE CORPORATION COMMISSION

WELL PLUGGING RECORD

Give All Information Completely  
Make Required Affidavit  
Mail or Deliver Report to  
Conservation Division  
State Corporation Comm.  
245 North Water  
Wichita, KS 67202

Rooks County. Sec. 5 Twp. 9S Rge. 16 EW  
Location as "NE/CNW\SW" or footage from lines  
100' from South Center of East Half SE/4

Lease Owner Louis M. Mai Operations  
Lease Name Brown Well No. #1  
Office Address Box 33 Russell, Kansas 67665  
Character of Well (Completed as Oil, Gas or Dry Hole)  
Dry Hole

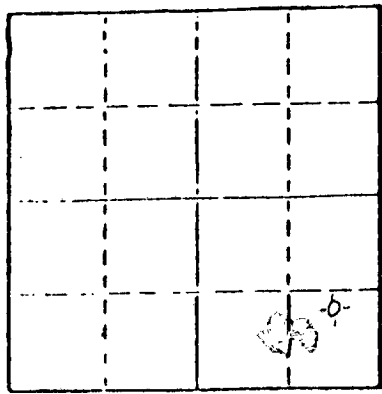

Locate well correctly on above Section Plot

Date Well completed April 24 1979  
Application for plugging filed April 24 1979  
Application for plugging approved April 24 1979  
Plugging commenced April 24, 4:30 P.M. 1979  
Plugging completed April 24, 6:45 P.M. 1979  
Reason for abandonment of well or producing formation  
No Commercial Production  
If a producing well is abandoned, date of last production 19

Was permission obtained from the Conservation Division or its agents before plugging was commenced? yes

Name of Conservation Agent who supervised plugging of this well Leo F. Massey  
Producing formation \_\_\_\_\_ Depth to top \_\_\_\_\_ Bottom \_\_\_\_\_ Total Depth of Well \_\_\_\_\_  
Show depth and thickness of all water, oil and gas formations.

OIL, GAS OR WATER RECORDS

CASING RECORD

FORMATION	CONTENT	FROM	TO	SIZE	PUT IN	PULLED OUT
surface casing	common	0	241.13'	8 5/8"	241.13'	0

Describe in detail the manner in which the well was plugged, indicating where the mud fluid was placed and the method or methods used in introducing it into the hold. If cement or other plugs were used, state the character of same and depth placed, from \_\_\_\_\_ feet to \_\_\_\_\_ feet for each plug set.

Plug #1 @ 550' with 70 sxs  
Plug #2 @ 240' with 20 sxs  
Plug #2 with Solid Bridge @ 40' with 10 sxs  
50-50 poz 6% gel  
Completion @ 6:45 P.M.

RECEIVED  
STATE CORPORATION COMMISSION

MAY - 7 1979  
5-7-1979  
CONSERVATION DIVISION  
Wichita, Kansas

(If additional description is necessary, use BACK of this sheet)


Name of Plugging Contractor Pioneer Drilling Company, Inc.  
308 West Mill Plainville, Kansas 67663

STATE OF Kansas COUNTY OF Russell, ss.  
Richard L. Mai (employee of owner) or owner or operator

of the above-described well, being first duly sworn on oath, says: That I have knowledge of the facts, statements, and matters herein contained and the log of the above-described well as filed and that the same are true and correct. So help me God.

(Signature) Richard L. Mai  
Box 33, Russell, Kansas 67665  
(Address)

SUBSCRIBED AND SWORN TO before me this 4th day of May, 1979

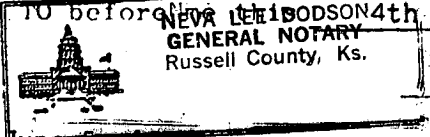

Neva Lee Dodson  
Neva Dodson Notary Public.

My commission expires June 9, 1981

WELL LOG

OPERATOR: Louis M. Mai Operations

WELL NAME: Brown #1 LOCATION: 100' from SC of E/2 SE/4 Sec. 5-9-16W

COUNTY: Rooks STATE: Kansas

WELL COMMENCED: April 17, 1979 WELL COMPLETED: April 24, 1979

ELEVATION: 2004' KB TOTAL DEPTH: 3391'

PRODUCTION: D & A RIG NO: #1

CASING - 8-5/8": 241.13' of 28# cemented with 140 sxs common 2% gel 3% cc  
5-1/2": none

ALL MEASUREMENTS TAKEN FROM THE TOP OF ROTARY BUSHING:

FROM	TO	FORMATION	DEVIATION FROM VERTICAL	REMARKS:
0'	250'	sand and shale	210' - 1 degree	
250'	309'			
309'	1253'	shales and sands	1058' - 1 degree	
1253'	1260'	Anhydrite		
1260'	1286'	Anhydrite		
1286'	1754'	shale		
1754'	1911'	shale		
1911'	2111'	shales and limes		
2111'	2329'	shale and lime		
2329'	2469'	shale and lime		
2469'	2670'	shale and lime		
2670'	2796'	shale and lime		
2796'	2910'	shale and lime		
2910'	3021'	lime and shale		
3021'	3112'	lime and shale		
3112'	3180'	lime and shale		
3180'	3204'	lime		
3204'	3262'	shale and lime		
3262'	3345'	lime		
3345'	3390'			
3390'	3391'	lime		
3391'	RTD			

RECEIVED  
STATE CORPORATION COMMISSION  
APR 30 1979  
4-30-1979  
CONSERVATION DIVISION  
Wichita, Kansas

STATE OF KANSAS  
COUNTY OF

The undersigned hereby certifies that to the best of his knowledge and belief, the above facts are true and correct

PIONEER DRILLING CO., INC.

By Charles D. Brown

SUBSCRIBED AND SWORN TO, BEFORE ME, This 27 day of 4, 1979

NOTARY PUBLIC  
ROGER L. COMEAU  
Ellis County, Kansas  
My Appt. Exp. 5-11-80

Roger L. Comeau  
NOTARY PUBLIC