


Give All Information Completely
Make Required Affidavit
Mail or Deliver Report to:
Conservation Division
State Corporation Commission
211 No. Broadway
Wichita, Kansas

WELL PLUGGING RECORD

Rooks County. Sec. 7 Twp. 9S Rge. (E) 16 (W)

Location as "NE/CNW/SW" or footage from lines NW SE SW
Lease Owner Bergman Drilling, Inc.
Lease Name Brown Well No. 1
Office Address 425 Union Center Bldg., Wichita 2, Kansas
Character of Well (completed as Oil, Gas or Dry Hole) dry hole
Date well completed December 7 1960
Application for plugging filed December 7 1960
Application for plugging approved December 7 1960
Plugging commenced December 7 1960
Plugging completed December 7 1960
Reason for abandonment of well or producing formation dry hole

NORTH

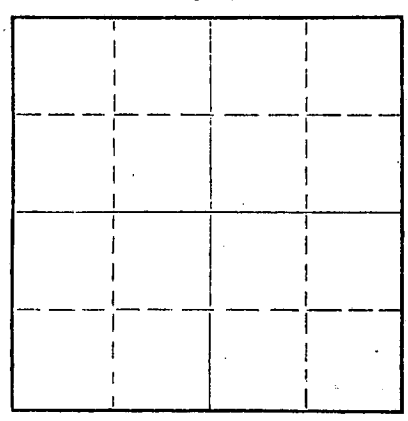

Locate well correctly on above
Section Plat

If a producing well is abandoned, date of last production no 19
Was permission obtained from the Conservation Division or its agents before plugging was commenced? yes

Name of Conservation Agent who supervised plugging of this well yes - Eldon Petty
Producing formation _____ Depth to top _____ Bottom _____ Total Depth of Well 3440 Feet
Show depth and thickness of all water, oil and gas formations.


OIL, GAS OR WATER RECORDS

CASING RECORD

FORMATION	CONTENT	FROM	TO	SIZE	PUT IN	PULLED OUT
surfaceday - sand - shale		0	238	8-5/8"	238	None

Describe in detail the manner in which the well was plugged, indicating where the mud fluid was placed and the method or methods used in introducing it into the hole. If cement or other plugs were used, state the character of same and depth placed, from top feet to bottom feet for each plug set.

First plug set at 480 feet with 20 sacks cement
Second plug set at 180 feet with 15 sacks cement, 1/2 sack hulls
Third plug set at 40 feet with 10 sacks cement and 1/2 sack hulls

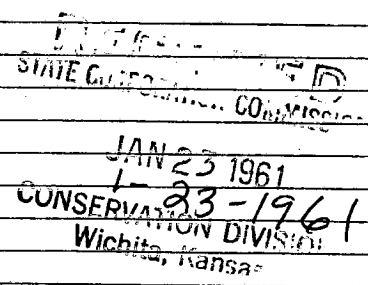

(If additional description is necessary, use BACK of this sheet)

Name of Plugging Contractor Bergman Drilling, Inc.
Address 425 Union Center Bldg., Wichita 2, Kansas

STATE OF KANSAS COUNTY OF SEDGWICK, ss.
Harold Bergman (employee of owner) or (owner or operator) of the above-described well, being first duly sworn on oath, says: That I have knowledge of the facts, statements, and matters herein contained and the log of the above-described well as filed and that the same are true and correct. So help me God.

(Signature) Harold Bergman
425 Union Center Bldg /, Wichita 2, Kansas
(Address)

Subscribed and Sworn to before me this 12th day of December, 19 60
My commission expires August 2, 1962



Harold Bergman
Notary Public.

DRILLER'S LOG

#1 Brown - NW SE SW
Section 7-9S-16W
Rooks County, Kansas

Date commenced: November 25, 1960
Date completed: December 7, 1960

Elevation: RB 1992

Surface casing: 238' 8-5/8" w/135 sacks


0	-	165	Surface clay - sand - shale
165	-	231	Shale - Shells
231	-	380	Shale - Shells
380	-	850	Shale - Shells
850	-	925	Sand - Shale
925	-	975	Sand
975	-	1250	Red Bed and Shale
1250	-	1270	Anhydrite
1270	-	1280	Anhydrite
1280	-	1620	Shale - Shells
1620	-	1840	Shale - Shells
1840	-	2010	Shale - Lime - Shales
2010	-	2140	Shale - Lime
2140	-	2215	Lime - Shale
2215	-	2355	Lime - Shale
2355	-	2425	Lime - Shale
2425	-	2490	Shale - Lime
2490	-	2615	Lime - Shale
2615	-	2725	Shale - Lime
2725	-	2805	Lime - Shale
2805	-	2880	Shale - Lime Shells
2880	-	2970	Lime - Shale
2970	-	3030	Lime - Shale
3030	-	3070	Lime
3070	-	3130	Lime - Shale
3130	-	3177	Lime - Shale
3177	-	3200	Lime
3200	-	3205	Lime
3205	-	3230	Lime
3230	-	3245	Lime
3245	-	3280	Lime
3280	-	3300	Lime
3300	-	3309	Lime
3309	-	3325	Lime
3325	-	3340	Lime
3340	-	3415	Lime - Shale
3415	-	3431	Lime
3431	-	3440	Arbuckle Lime
3440			Total Depth - Plugged and abandoned

RECEIVED
STAT. CORPORATION COMMISSION
JAN 23 1961
1-23-1961
CONSERVATION DIVISION
Wichita, Kansas

A F F I D A V I T

STATE OF KANSAS)
) SS.
COUNTY OF SEDGWICK)

I, do swear that the statements and matter herein contained are true to the best of my knowledge.

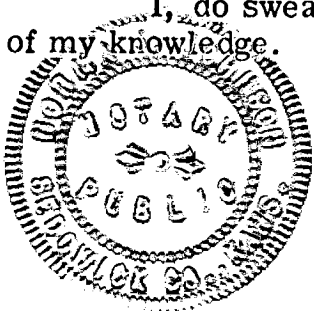

BERGMAN DRILLING, INC.

Harold Bergman
Harold Bergman

Subscribed and sworn to before me this 12th day of December, 1960.

NORMA J. JOHNSON, Notary Public
Commission Expires Aug. 2, 1967

Norma J. Johnson
Notary Public