


15-163-19217-0001

Give All Information Completely
Make Required Affidavit
Mail or Deliver Report to:
Conservation Division
State Corporation Commission
211 No. Broadway
Wichita, Kansas

WELL PLUGGING RECORD

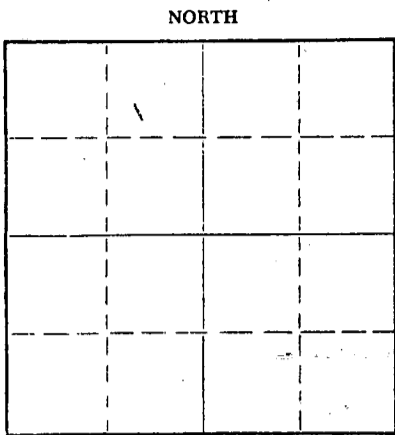

Locate well correctly on above Section Plat

Rooks

County. Sec. 8 Twp. 9 Rge. 16W (E) (W)

Location as "NE/CNW/SW" or footage from lines CS/2 SW NW

Lease Owner Ryan Consolidated Petr. Corp.

Lease Name G. P. Brown Well No. 1

Office Address 3400 Republic Natl. Bank Bldg., Dallas, Texas

Character of Well (completed as Oil, Gas or Dry Hole) Dry

Date well completed 2-18-63 19

Application for plugging filed 2-17-63 19

Application for plugging approved 2-18-63 19

Plugging commenced 2-18-63 19

Plugging completed 2-18-63 19

Reason for abandonment of well or producing formation Dry Hole

Wash Down

If a producing well is abandoned, date of last production None 19

Was permission obtained from the Conservation Division or its agents before plugging was commenced? Yes

Name of Conservation Agent who supervised plugging of this well Eldon Petty - Hays

Producing formation None Depth to top _____ Bottom _____ Total Depth of Well 3552 Feet

Show depth and thickness of all water, oil and gas formations.

OIL, GAS OR WATER RECORDS

CASING RECORD

FORMATION	CONTENT	FROM	TO	SIZE	PUT IN	PULLED OUT

Describe in detail the manner in which the well was plugged, indicating where the mud fluid was placed and the method or methods used in introducing it into the hole. If cement or other plugs were used, state the character of same and depth placed, from _____ feet to _____ feet for each plug set.

Filled with heavy mud. 1st cement plug 600' - 20 sax cement

2nd cement plug 150' 20 sax cement

3rd cement plug 35' 10 sax cement

Well originally drilled by Falcon-Seaboard as Chesney #1, started January 6, 1943 - P&A January 27, 1963 --- dry hole

RECEIVED
STATE CORPORATION COMMISSION

AUG 30 1963

CONSERVATION DIVISION
Wichita, Kansas

8-30-63

(If additional description is necessary, use BACK of this sheet)
Name of Plugging Contractor Bergman Drilling Company
Address Wichita, Kansas

STATE OF TEXAS, COUNTY OF DALLAS, ss.
Walter Ziegler (employee of owner) or (owner or operator) of the above-described

well, being first duly sworn on oath, says: That I have knowledge of the facts, statements, and matters herein contained and the log of the above-described well as filed and that the same are true and correct. So help me God.

(Signature) Walter Ziegler

3400 Republic Natl. Bank Bldg., Dallas, Texas
(Address)

SUBSCRIBED AND SWORN to before me this 31st day of August, 1963

ELIZABETH A. REAVES, Notary Public
in and for Dallas County, Texas
My Commission Expires June 1, 1965

Elizabeth A. Reaves
Notary Public.

