


STATE OF KANSAS
STATE CORPORATION COMMISSION

Get All Information Completely
Make Required Affidavit
Mail or Deliver Report to:
Conservation Division
State Corporation Commission
800 Bitting Building
Wichita, Kansas

WELL PLUGGING RECORD

NORTH

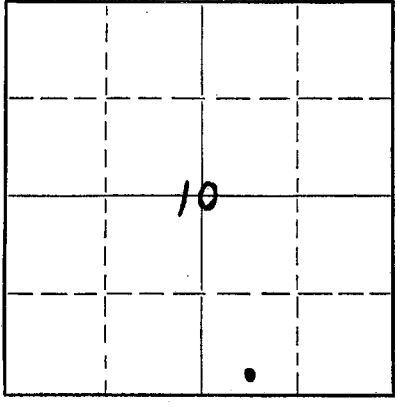

Locate well correctly on above
Section Plat

Rooks _____ County. Sec. 10 Twp. 9 Rge. 16 (W)
Location as "NE/CNW $\frac{1}{4}$ SW $\frac{1}{4}$ " or footage from lines 330' N + 460 E. 20 ACRE
Lease Owner Harold Krueger
Lease Name Tatkenhorst Well No. 4 B
Office Address Natoma, Kansas
Character of Well (completed as Oil, Gas or Dry Hole) _____
Date well completed JUNE 1ST 1941
Application for plugging filed _____ 19 _____
Application for plugging approved 1-18-52 1952
Plugging commenced 1-19-52 19 _____
Plugging completed 1-27-52 19 _____
Reason for abandonment of well or producing formation DRY
If a producing well is abandoned, date of last production SEPT 1950
Was permission obtained from the Conservation Division or its agents before plugging was commenced? Yes

Name of Conservation Agent who supervised plugging of this well Eldon Petty
Producing formation K.C. LIME Depth to top 3225 Bottom 3310 Total Depth of Well 3310 Feet
Show depth and thickness of all water, oil and gas formations.

OIL, GAS OR WATER RECORDS

CASING RECORD

Formation	Content	From	To	Size	Put In	Pulled Out
				5-1/2"	3325	1602'

Describe in detail the manner in which the well was plugged, indicating where the mud fluid was placed and the method or methods used in introducing it into the hole. If cement or other plugs were used, state the character of same and depth placed, from _____ feet to _____ feet for each plug set.

Rocked hole from 2965' to 2950' and ran 4 sacks of cement. Mudded hole to 200', set 10' rock bridge and ran 20 sacks of cement. Mudded hole to 35', set rock bridge and ran 10 sacks of cement. Plugging completed.

(If additional description is necessary, use BACK of this sheet)

Name of Plugging Contractor West Supply Company
Address Chase, Kansas

STATE OF Kansas, COUNTY OF Osborne, ss.
Harold Krueger (employee of owner) or (owner or operator) of the above-described well, being first duly sworn on oath, says: That I have knowledge of the facts, statements, and matters herein contained and the log of the above-described well as filed and that the same are true and correct. So help me God.

(Signature) Harold Krueger

Natoma, Kansas (Address)

SUBSCRIBED AND SWORN to before me this 7th day of February, 1952
January 9, 1956
My commission expires _____



Notary Public

PLUGGING
FILE SEC 10 T 9 R 16
BOOK PAGE 142 LINE 7


FEB 9 X 1952
CONSERVATION DIVISION
Wichita, Kansas
2-9-1952

KRUEGER OIL CO.
Tatkenhorst "B" No. 4.

SEC.10 T. 9 R.16W
CSL SW SE

Total Depth. 3275'
Comm. 4-27-41 Comp. 6-24-41
Shot or Treated.
Contractor. H.B.Mabee
Issued. 10-11-41

County. Rocks

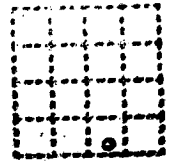

CASING:

5 3/16" 3226'

Elevation.

Production. Pot.803 B.

Figures Indicate Bottom of Formations

shale	465
shale & shells	760
sand	850
sand shale & shells	1002
red rock & shells	1315
anhydrite	1345
shale, shells, red bed	1590
shale & shells	1660
salt	1730
shale & shells	1856
lime brkn	1956
shale & lime	2610
shale & shells	2679
shale & lime	2800
lime	2828
shale & lime	2915
lime	3144
shale & lime	3196
<hr/>	
3196 equals 3193 Steel tape corr.	
lime & shale cored	3209
shale	3221
lime & shale cored	3237
lime?	3275
Total Depth.	

PLUGGING
WELL NO. 10 T-9-2 (low)
BACK PART LINE 7

2 1952

2-22-1952