


STATE OF KANSAS
STATE CORPORATION COMMISSION
200 Colorado Derby Bldg.
Wichita, Kansas 67202

Form CP-4
Rev. 12-15-80

WELL PLUGGING RECORD

Give All Information Completely
Make Required Affidavit

COUNTY _____ Rooks SEC. 10 TWP. 9 RGE. 16 E/W
Location as in quarters or footage from lines:
SW-SW-NE

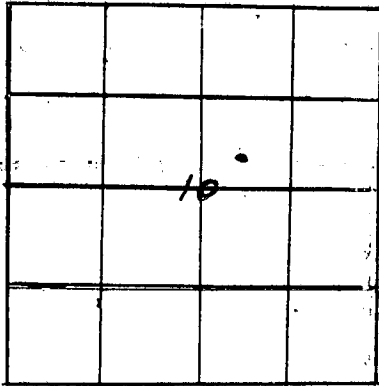

Locate Well
correctly on above
Section Platt.

Lease Owner Harold Krueger Co.
Lease Name Beardmore Well No. 2
Office Address P.O. Box 247, Natoma, Kansas 67651
Character of Well (Completed as Oil, Gas or Dry Hole): _____
Date Well Completed Don't know. Old well. No logs
Application for plugging filed 3-29-83
Plugging commenced 5-3-83
Plugging completed 5-3-83
Reason for abandonment of well or producing formation _____

No Productions

Was permission obtained from the Conservation Division or it's
Agent's before plugging was commenced? yes

Name of Conservation Agent who supervised plugging of this well Dennis Hamel
Producing formation KC Lime Depth to top _____ bottom _____ T.D. 3234

Show depth and thickness of all water, oil and gas formations.

OIL, GAS OR WATER RECORDS

Casing Record

Formation	Content	From	To	Size	Put in	Pulled Out
KC Lime	Oil			5 1/2		None

Describe in detail the manner in which the well was plugged, indicating where the mud
fluid was placed and the method or methods used in introducing it into the hold. If cement
or other plugs were used, state the character of same and depth placed, from _____ feet
to _____ feet for each plug set.

Hooked up to casing. Pumped 50 sks. cement and 5 sks. hulls.
Pumped in 135 sks. cement. Circulated to surface. Standing full of cement.
Shut in. Job complete. Well plugged

(If additional description is necessary, use BACK of this sheet)

Name of Plugging Contractor Halliburton, Hays, Kansas

STATE OF KANSAS COUNTY OF OSBORNE, ss.

Dean Wineland (employee of owner) ~~or (owner or operator)~~ of the
above-described well, being first duly sworn on oath, says: That I have knowledge of the
facts, statements, and matters herein contained and the log of the above-described well as
filed and that the same are true and correct. So help me God.

(Signature) Dean Wineland
Natoma, Kansas 67651
(Address)

SUBSCRIBED AND SWORN TO before me this 17th day of May, 19 83
Della M. Richmond
Notary Public.

My Commission expires: 7-12-88 RECEIVED
STATE CORPORATION COMMISSION

5-18-1983
MAY 18 1983

DELLA M. RICHMOND
STATE NOTARY PUBLIC
OSBORNE COUNTY, KANSAS
My Appt. Exp. _____