

WELL PLUGGING RECORD

STATE OF KANSAS
STATE CORPORATION COMMISSION

Give All Information Completely
Make Required Affidavit
Mail or Deliver Report to:
Conservation Division
State Corporation Commission
800 Bitting Building
Wichita, Kansas

FORMATION PLUGGING RECORD

Strike out upper line
when reporting plug-
ging off formations.

Rooks County. Sec. 10 Twp. 9 Rge. (E) 16 (W)

Location as "NE $\frac{1}{4}$ NW $\frac{1}{4}$ SW $\frac{1}{4}$ " or footage from lines. C W/2 SE NE

Lease Owner. Cooperative Refinery Association

Lease Name. Beardmore Well No. 3

Office Address. 402 Schweiter Bldg., Wichita, Kansas

Character of Well (completed as Oil, Gas or Dry Hole). Oil well

Date well completed. 10-25 19 40

Application for plugging filed. 11-18 19 47

Application for plugging approved. 11-19 19 47

Plugging commenced. 1-2 19 47


Plugging completed. 1-16 19 48

Reason for abandonment of well or producing formation. Producing less than 1/4 barrels per day

If a producing well is abandoned, date of last production. November 19 47

Was permission obtained from the Conservation Division or its agents before plugging was commenced? Yes

NORTH

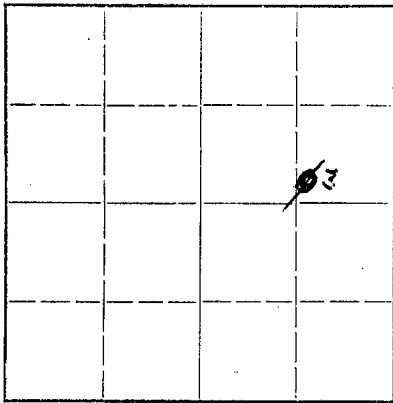

Locate well correctly on above Section Plat

Name of Conservation Agent who supervised plugging of this well. C. D. Stough

Producing formation. L. C. Lime Depth to top. 3200' Bottom. 3218' Total Depth of Well. 3218 Feet

Show depth and thickness of all water, oil and gas formations.

OIL, GAS OR WATER RECORDS

CASING RECORD

Formation	Content	From	To	Size	Put In	Pulled Out
				5 1/2	3163'	1900'

Describe in detail the manner in which the well was plugged, indicating where the mud fluid was placed and the method or methods used in introducing it into the hold. If cement or other plugs were used, state the character of same and depth placed, from _____ feet to _____ feet for each plug set.

Filled with Chert to 3160', dumped 7 1/2 sacks cement, at this depth, mudded to 1200' of top, put in rock bridge, dumped 55 sacks cement at this depth, filled to 30' of top, bridged and ran 10 sacks cement, filled to surface.

Handwritten stamp:
JAN 20 1948
1-20-1948

(If additional description is necessary, use BACK of this sheet)

Correspondence regarding this well should be addressed to. Cooperative Refinery Association
Address. 402 Schweiter Bldg., Wichita, Kansas

STATE OF Kansas, COUNTY OF Sedgwick, ss.
O. W. Gosnell (employee of owner) or (owner or operator) of the above-described well,
being first duly sworn on oath, says: That I have knowledge of the facts, statements, and matters herein contained and the log of the above-described well as filed and that the same are true and correct. So help me God.

(Signature) O. W. Gosnell


402 Schweiter Bldg., Wichita, Kansas
(Address)

SUBSCRIBED AND SWORN to before me this 19th day of January, 19 48

Ruth V. Howe
Notary Public.

Jan 5, 1949

PLUGGING
FILE SEC 10-T-9-R-16a
BOOK PAGE 48 LINE 5

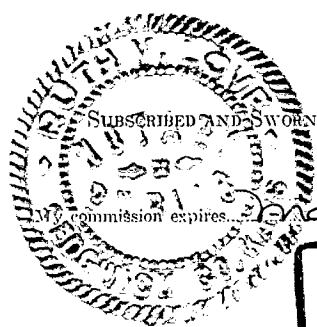

THE COOPERATIVE PIPE LINE ASS'N
Beardmore No. 3

SEC. 10 T. 9 R. 16W
CW¹/₂ SE NE

Total Depth 3218
Comm 10-9-40 Comp. 10-25-40
Shot or Treated
Contractor The Springrose Drilling Co.
Issued 11-30-40

COUNTY Rooks

CASING

Production Pot. 2385 B.

5¹/₂" 3163'

Elevation

Figures Indicate Bottom of Formations.

Clay shale and shells	200
Shale and shells	590
sand and shale	645
shale and shells	950
red rock and shells	1020
red bed and shale	1265
anhydrite	1305
red bed	1340
shale and shells	1815
broken lime	2155
lime	2205
lime and shale	2785
shale	2860
broken lime	2915
shale and lime	3055
lime	3085
shale	3140
K. C. lime	3218

Total Depth.

NOV 19 1947
7 1781-61-11
11-19-1947

PLUGGING
FILE SEC-10 T-9 R-16W
BOOK PAGE 148 LINE 5