


STATE OF KANSAS
STATE CORPORATION COMMISSION
200 Colorado Derby Bldg.
Wichita, Kansas 67202

WELL PLUGGING RECORD

Give All Information Completely
Make Required Affidavit

COUNTY Rooks SEC. 10 TWP. 9 RGE. 16 E/W (1)
Location as in quarters or footage from lines:
C N/2 SW NE/4

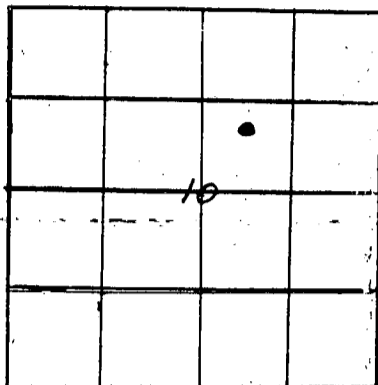

Locate Well
correctly on above
Section Platt.

Lease Owner Harold Krueger Co.
Lease Name Beardmore Well No. 4
Office Address Box 247, Natoma, Kansas 67651
Character of Well (Completed as Oil) Gas or Dry Hole):
Date Well Completed 11-6-1940
Application for plugging filed 6-5-85
Plugging commenced 6-10-85
Plugging completed 6-10-85
Reason for abandonment of well or producing formation
Dakota broke in. Couldn't squeeze.

Was permission obtained from the Conservation Division or it's
Agent's before plugging was commenced? yes

Name of Conservation Agent who supervised plugging of this well Dennis Hamel
Producing formation KC Lime Depth to top 3179 bottom 3211 T.D. 3211

Show depth and thickness of all water, oil and gas formations.

OIL, GAS OR WATER RECORDS Casing Record

Formation	Content	From	To	Size	Put in	Pulled Out
KC Lime	Oil			5 1/2	3166	None

Describe in detail the manner in which the well was plugged, indicating where the mud fluid was placed and the method or methods used in introducing it into the hold. If cement or other plugs were used, state the character of same and depth placed, from _____ feet to _____ feet for each plug set.

Ran tubing to bottom (3200'). Spotted 100 sx. cement with 2 sx. hulls. Ran measuring line . T.O.C. 1990'. Pulled tubing. Shot casing at 1300' and 600'. Pumped in additional 200 sx. cement. Max. P.S.I. 150#. Shut in 75# P.S.I. Job complete.

RECEIVED
STATE CORPORATION COMMISSION

JUN 20 1985
6-20-1985
CONSERVATION DIVISION
Wichita, Kansas

(If additional description is necessary, use BACK of this sheet)

Name of Plugging Contractor Halliburton, Hays, Kansas

STATE OF KANSAS COUNTY OF Osborne, ss.
Dean Wineland (employee of owner) or (~~owner or operator~~) of the above-described well, being first duly sworn on oath, says: That I have knowledge of the facts, statements, and matters herein contained and the log of the above-described well as filed and that the same are true and correct. So help me God.

(Signature) Dean Wineland
Natoma, Kansas 67651
(Address)

SUBSCRIBED AND SWORN TO before me this 18th day of June, 1985

Lois A. Doty
Notary Public.

My Commission expires: 12-15-88



1 PACKERS
 2 CLEANOUT RECORD
 3 REFLECTION RECORD
 4 LOGGING RECORD
 5 WELL LOG
 6 CASING RECORD
 7 ACIDIZING RECORD
 8 PRODUCING METHOD
 9 SAND RECORD
 10 TORQUE RECORD
 11 SWABING RECORD

Co-op LEASE
 COMPANY Cooperative Oil Producing Ass'n ACRES 20
 RECORD COMPILED 10-20 1943 BY MBucknan
 SEC. 10 TWP9S RGE. 16W COUNTY Rooks STATE Kansas
 SURVEY 990' N 660' E of SW Cor BLOCK SECTION
 LOCATION Center N $\frac{1}{2}$ SW $\frac{1}{2}$ NE $\frac{1}{2}$ 15-163-03731-00-07
 STAKED BY Beardmore DATE 10-23 1940 ELEVATION 2015
 RIG COMMENCED 10-23 1940 COMPLETED 11-6 1940 CONTR Springrose

TOOLS	STARTED	COMPLETED	FROM	TO	CONTRACTOR
ROTARY	10-23-40	11-4-40	- 0 -	3158'	Springrose
CABLE	11-5-40	11-6-40	3158'	3211'	

COMPLETION METHOD cable tool
 PRODUCTION DATA 3000 initial potential - Depthograph
 GAS WELL SHUT-IN PRESSURE VOLUME M. CU. FT.

CASING AND TUBING RECORD

DEPTH	CASING SIZE	WT.	THDS.	MAKE, TYPE, GRADE, NEW, USED	CASING POINT	PULLED	LEFT IN	CEMENT		REMARKS
								BACKS	ESTIMATED WT.	
3162	5 1/2"									
3189	2		10	upset tubing						
3194	5/8"			Jones rods 2 pins						
10'	Hanse tubing working barrels									
10'	line pipe									
15'	Polish rod									
	Regular House valves 1 25/32 cups									

(2) ACIDIZING RECORD

DATE 11-8-40
 QUANTITY (GAL.) 8000
 MAX. TUB. PR.
 MAX. GAS PR.
 BLANKET
 HOURS
 METHOD

(3) PRODUCING METHODS

WELL FLOWING NATURAL FROM 15 TO 19
 PRODUCED BY GAS LIFT - IN TUBING FROM 15 TO 19
 OTHER LIFTS
 PUT ON JACK/BEAM/UNIT Emco Type D-58, Bar. 58H150
 Allis-Chalmers 10 HP 1740 RPM

(4) SAND RECORD

	NAME	TOP	BOTTOM	THICKNESS	CONTENT	COLOR OR S
OIL BEFORE	Anhydrite	1298'				
OIL AFTER	Topeka					
WATER BEFORE	Lansing					
WATER AFTER	Kansas City	3138				
DONE BY	First Pay	3165				
	Second Pay	3208	3211.5			

(CONTINUED)