


STATE OF KANSAS
STATE CORPORATION COMMISSION
200 Colorado Derby Bldg.
Wichita, Kansas 67202

WELL PLUGGING RECORD

Give All Information Completely
Make Required Affidavit

COUNTY Rooks SEC. 10 TWP. 9 RGE. 16 ~~NE~~/W
Location as in quarters or footage from lines:
NE-NE-NE

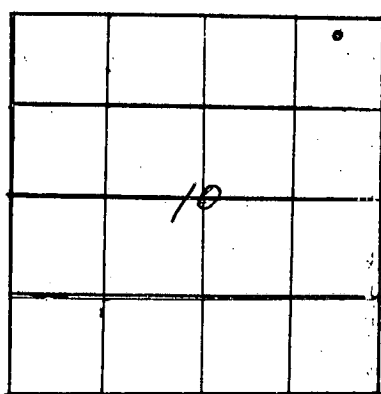

Locate Well
correctly on above
Section Platt.

Lease Owner Harold Krueger Co.
Lease Name Beardmore Well No. 7
Office Address P.O. Box 247, Natoma, Kansas 67651
Character of Well (Completed as Oil Gas or Dry Hole):
Date Well Completed Co-Op drilled this well. Don't know when.
Application for plugging filed 4-27-83
Plugging commenced 5-5-83
Plugging completed 5-5-83
Reason for abandonment of well or producing formation
No Production

Was permission obtained from the Conservation Division or it's
Agent's before plugging was commenced? yes

Name of Conservation Agent who supervised plugging of this well Dennis Hamel
Producing formation KC Lime Depth to top _____ bottom _____ T.D. 3192

Show depth and thickness of all water, oil and gas formations.

OIL, GAS OR WATER RECORDS Casing Record

Formation	Content	From	To	Size	Put in	Pulled Out
KC Lime	Oil			5 1/2		None

Describe in detail the manner in which the well was plugged, indicating where the mud fluid was placed and the method or methods used in introducing it into the hold. If cement or other plugs were used, state the character of same and depth placed, from _____ feet to _____ feet for each plug set.

Ran wire line with flag. Found hole at 924 ft. with solid bridge at 2945 ft. Pumped in 150 sks. cement with 6% gel and 4% cc. and 1 sks. hulls. Plug at 800 ft. Perforated at 500 ft. Ran 50 sks. of 50/50 pozmix with additives. Plug down at 465 ft. with 1300 PSI standing pressure. Perforated at 250 ft. Pressured to 500 PSI. Held. Perforated at 150 ft. Pumped in another 100 sks. cement and circulated to surface. Shut in. Well plugged. Job complete.

(If additional description is necessary, use BACK of this sheet)

Name of Plugging Contractor Halliburton, Hays, Kansas

STATE OF KANSAS COUNTY OF OSBORNE, ss.
Dean Wineland (employee of owner) ~~or (owner or operator)~~ of the above-described well, being first duly sworn on oath, says: That I have knowledge of the facts, statements, and matters herein contained and the log of the above-described well as filed and that the same are true and correct. So help me God.

(Signature) Dean Wineland
Natoma, Kansas 67651
(Address)

SUBSCRIBED AND SWORN TO before me this 12th day of May, 19 83
Della M. Richmond
Notary Public.

My Commission expires: 2-13-84 RECEIVED STATE CORPORATION COMMISSION

5-13-1983
MAY 13 1983

DELLA M. RICHMOND
STATE NOTARY PUBLIC
OSBORNE COUNTY, KANSAS
My Appt. Exp. _____