

KANSAS CORPORATION COMMISSION
OIL & GAS CONSERVATION DIVISION

Form ACO-1
September 1999
Form Must Be Typed

WELL COMPLETION FORM
WELL HISTORY - DESCRIPTION OF WELL & LEASE

ORIGINAL

Operator: License # 6766
Name: N & W Enterprises, Inc
Address: 1111 S Margrave
City/State/Zip: Fort Scott, KS 66701
Purchaser: Plains Marketing
Operator Contact Person: Tom Norris
Phone: (620) 223-6559
Contractor: Name: McGown Drilling, Inc
License: 5786
Wellsite Geologist: N/A

RECEIVED
APR 21 2005
KCC WICHITA

Designate Type of Completion:
 New Well Re-Entry Workover
 Oil SWD SLOW Temp. Abd.
 Gas ENHR SIGW
 Dry Other (Core, WSW, Expl., Cathodic, etc)

If Workover/Re-entry: Old Well Info as follows:
Operator: _____

Well Name: _____
Original Comp. Date: _____ Original Total Depth: _____
 Deepening Re-perf. Conv. to Enhr./SWD
 Plug Back Plug Back Total Depth
 Commingled Docket No. _____
 Dual Completion Docket No. _____
 Other (SWD or Enhr.?) Docket No. _____

3/31/05	04/01/05	04/01/05
Spud Date or Recompletion Date	Date Reached TD	Completion Date or Recompletion Date

API No. 15 - 037-21671-00-00
County: Crawford
N/2 SW 1/4 Sec. 34 Twp. 28 S. R. 22 East West
1980 feet from S N (circle one) Line of Section
3960 feet from E W (circle one) Line of Section

Footages Calculated from Nearest Outside Section Corner:
(circle one) NE SE NW SW
Lease Name: Giefer Well #: 15

Field Name: Walnut SE
Producing Formation: Bartlesville

Elevation: Ground: _____ Kelly Bushing: _____
Total Depth: 425' Plug Back Total Depth: 423'

Amount of Surface Pipe Set and Cemented at 20' Feet
Multiple Stage Cementing Collar Used? Yes No

If yes, show depth set _____ Feet
If Alternate II completion, cement circulated from 423'
feet depth to top w/ 50 sx cmt.

Drilling Fluid Management Plan *ALT II with 8-16-07*
(Data must be collected from the Reserve Pit)
Chloride content _____ ppm Fluid volume _____ bbls
Dewatering method used _____

Location of fluid disposal if hauled offsite: _____
Operator Name: _____
Lease Name: _____ License No.: _____
Quarter _____ Sec. _____ Twp. _____ S. R. _____ East West
County: _____ Docket No.: _____

INSTRUCTIONS: An original and two copies of this form shall be filed with the Kansas Corporation Commission, 130 S. Market - Room 2078, Wichita, Kansas 67202, within 120 days of the spud date, recompletion, workover or conversion of a well. Rule 82-3-130, 82-3-106 and 82-3-107 apply. Information of side two of this form will be held confidential for a period of 12 months if requested in writing and submitted with the form (see rule 82-3-107 for confidentiality in excess of 12 months). One copy of all wireline logs and geologist well report shall be attached with this form. ALL CEMENTING TICKETS MUST BE ATTACHED. Submit CP-4 form with all plugged wells. Submit CP-111 form with all temporarily abandoned wells.

All requirements of the statutes, rules and regulations promulgated to regulate the oil and gas industry have been fully complied with and the statements herein are complete and correct to the best of my knowledge.

Signature: Thomas L. Norris
Title: Pres. Date: 4/17/05
Subscribed and sworn to before me this 17th day of April,
2005
Notary Public: Virginia L. Norris
Date Commission Expires: 3-30-09

KCC Office Use ONLY
NO Letter of Confidentiality Received
If Denied, Yes Date: _____
 Wireline Log Received
 Geologist Report Received
 UIC Distribution

NOTARY PUBLIC - State of Kansas
VIRGINIA L. NORRIS
My Appt. Exp. _____

Operator Name: N & W Enterprises, Inc Lease Name: Giefer Well #: 15
 Sec. 34 Twp. 28 S. R. 22 East West County: Crawford

INSTRUCTIONS: Show important tops and base of formations penetrated. Detail all cores. Report all final copies of drill stems tests giving interval tested, time tool open and closed, flowing and shut-in pressures, whether shut-in pressure reached static level, hydrostatic pressures, bottom hole temperature, fluid recovery, and flow rates if gas to surface test, along with final chart(s). Attach extra sheet if more space is needed. Attach copy of all Electric Wireline Logs surveyed. Attach final geological well site report.

Drill Stem Tests Taken <input type="checkbox"/> Yes <input checked="" type="checkbox"/> No <i>(Attach Additional Sheets)</i> Samples Sent to Geological Survey <input type="checkbox"/> Yes <input checked="" type="checkbox"/> No Cores Taken <input type="checkbox"/> Yes <input checked="" type="checkbox"/> No Electric Log Run <input checked="" type="checkbox"/> Yes <input type="checkbox"/> No <i>(Submit Copy)</i> List All E. Logs Run: Gamma Ray Neutron	<input type="checkbox"/> Log Formation (Top), Depth and Datum <input type="checkbox"/> Sample Name <u>Bartlesville</u> Top <u>382'</u> Datum <u>392'</u>
--	---

CASING RECORD <input type="checkbox"/> New <input checked="" type="checkbox"/> Used							
Report all strings set-conductor, surface, intermediate, production, etc.							
Purpose of String	Size Hole Drilled	Size Casing Set (In O.D.)	Weight Lbs. / Ft.	Setting Depth	Type of Cement	# Sacks Used	Type and Percent Additives
Surface	12"	8 5/8"	6 lbs	20'	Portland #1	5	None
Production	6 3/4"	2 7/8" 8 rnd	6.5 lbs	423'	Portland #1	50	None

ADDITIONAL CEMENTING / SQUEEZE RECORD				
Purpose:	Depth Top Bottom	Type of Cement	#Sacks Used	Type and Percent Additives
<input type="checkbox"/> Perforate <input type="checkbox"/> Protect Casing <input type="checkbox"/> Plug Back TD <input type="checkbox"/> Plug Off Zone				

Shots Per Foot	PERFORATION RECORD - Bridge Plugs Set/Type Specify Footage of Each Interval Perforated	Acid, Fracture, Shot, Cement Squeeze Record <i>(Amount and Kind of Material Used)</i>	Depth
2	382' to 392'	30 Sack Sand Fracs	382-392'
		RECEIVED	
		APR 21 2005	
		KCC WICHITA	

TUBING RECORD		Size <u>2 7/8 8 rnd</u>	Set At <u>423;</u>	Packer At	Liner Run <input type="checkbox"/> Yes <input checked="" type="checkbox"/> No
Date of First, Resumerd Production, SWD or Enhr. <u>04/15/2005</u>		Producing Method <input type="checkbox"/> Flowing <input checked="" type="checkbox"/> Pumping <input type="checkbox"/> Gas Lift <input type="checkbox"/> Other <i>(Explain)</i>			
Estimated Production Per 24 Hours	Oil Bbls. <u>1 bbl</u>	Gas Mcf	Water Bbls. <u>10</u>	Gas-Oil Ratio	Gravity <u>29.6</u>

Disposition of Gas Vented Sold Used on Lease *(If vented, Submit ACO-18.)*

METHOD OF COMPLETION Open Hole Perf. Dually Comp. Commingled

Production Interval Other *(Specify)* _____

ORIGINAL

Plat and Certificate of Injection Well Location and Surrounding Acreages

Operator: N & W Enterprises Location of Well: (s) - SW 1/4


Lease: Giefer Feet from SOUTH Section Line

Well Number: Plat Map Feet from EAST Section Line

County: Crawford Sec. 34 Twp. 28 S. R. 22 East West

Plat

Show the following information: applicant injection well, all producing wells, inactive wells, plugged wells, and other wells within a one-half mile radius, all lease boundaries, lease operators, unleased mineral rights owners, well numbers, and producing wells producing formation tops.

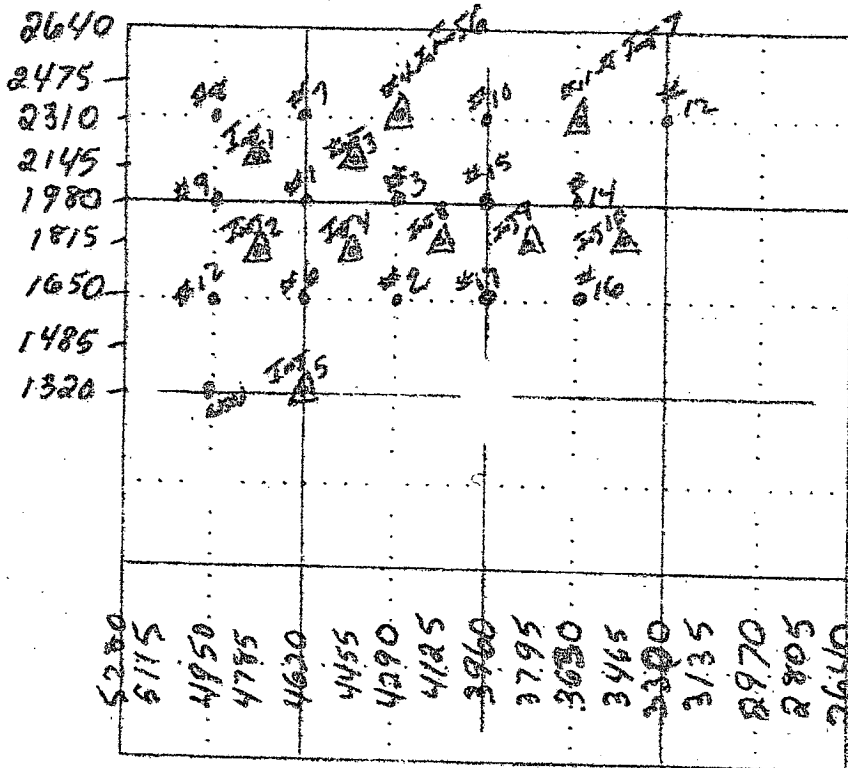

RECEIVED
 APR 21 2005
 KCC WICHITA

- applicant well
- producing well
- plugged injection well
- D & A well
- other injection well
- temporary abandoned well
- plugged producer
- water supply well

The undersigned hereby certifies that he / she is a duly authorized agent for N & W Enterprises Inc. and that all of the information shown herein is true, complete and correct to the best of his / her knowledge.

Thomas L. Spauld *Pres.*
Applicant or Duly Authorized Agent

Subscribed and sworn before me this 17th day of April 2005

Virginia L. Norris
Notary Public

My Commission Expires: 3-30-09

