

15-173-03272-00-00


STATE OF KANSAS  
STATE CORPORATION COMMISSION

WELL PLUGGING RECORD

Give All Information Completely  
Make Required Affidavit  
Mail or Deliver Report to:  
Conservation Division  
State Corporation Commission  
800 Bittling Building  
Wichita, Kansas

Sedgwick County, Sec. 19 Twp. 26s Rge. 2e (E) (W)

Location as "NE/CNW $\frac{1}{4}$ SW $\frac{1}{4}$ " or footage from lines SE NW SE  
Lease Owner Berry & Fells  
Lease Name Ratzlaff Well No. 2  
Office Address Box 206 Newton Kansas  
Character of Well (completed as Oil, Gas or Dry Hole) Dry Hole  
Date well completed 2-22-52 19  
Application for plugging filed 3-1-52 19  
Application for plugging approved 19  
Plugging commenced 2-12-52 19  
Plugging completed 2-12-52 19  
Reason for abandonment of well or producing formation Dry Hole  
If a producing well is abandoned, date of last production 19  
Was permission obtained from the Conservation Division or its agents before plugging was commenced? yes

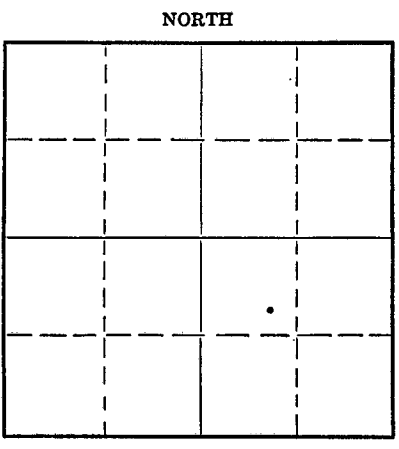

Locate well correctly on above Section Plat

Name of Conservation Agent who supervised plugging of this well Mr. D. G. Lilly  
Producing formation Depth to top Bottom Total Depth of Well 3002 1/2 Feet  
Show depth and thickness of all water, oil and gas formations.

OIL, GAS OR WATER RECORDS

CASING RECORD

Formation	Content	From	To	Size	Put In	Pulled Out
Surface Pipe	100' of 8-5/8" Casing					

Describe in detail the manner in which the well was plugged, indicating where the mud fluid was placed and the method or methods used in introducing it into the hole. If cement or other plugs were used, state the character of same and depth placed, from 150' feet to 0 feet for each plug set.


Filled Hole with heavy drilling mud to 150', set wooden plug w/ 15 sax of cement at 150'. Filled hole with heavy drilling mud within 10' of top of hole, set wooden plug and 10 sax of cement. to top of ground level.

(If additional description is necessary, use BACK of this sheet)

Name of Plugging Contractor Capitt Drilling, Inc.  
Address 619 Brown Bldg. Wichita 2, Kansas

STATE OF Kansas, COUNTY OF Sedgwick, ss.  
Capitt Drilling, Inc. Contractor  
being first duly sworn on oath, says: That I have knowledge of the facts, statements, and matters herein contained and the log of the above-described well as filed and that the same are true and correct. So help me God.

(Signature) Lester J. Capitt  
619 Brown Bldg. Wichita  
March 1952 (Address)

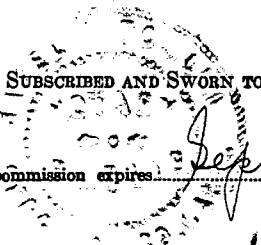

SUBSCRIBED AND SWORN to before me this 3rd day of March, 1952  
My commission expires Sept. 13-1955  
Hazel Jomlin Notary Public.

23-8390-s 6-51-20M

PLUGGING  
FILE SEC 19 T 26 R 2E  
BOOK PAGE 143 LINE 40

Rotary Drilling Log

Berry & Eells	Contractor: Capitt Drilling, Inc.
Ratzlaff #2	Date Started 2-5-52
SE*NW-SE 19-25-2e	Date Completed 2-12-52
Sedgwick County	Elev: <u>?</u>
Casing Record	Prod: <u>DEA</u>
100' - 8 5/8" Surface Pipe	

100-300	Line & shale (broken)	Tops:
315	Red Rock	Kansas City 2518'
655	Lime & shale ( broken)	Miss. Chert 2986'
915	Shale & shells	
960	Lime & shale ( broken )	
1320	Shale & shells	
1630	Shale & lime	
1645	Shale & shells	
2190	Lime & shale	
2325	Lime	
2518	Shale & lime	
2684	Lime	
2780	Shale & lime shells	
2790	Lime	
2805	Shale & lime	
2813	Shale & shells	
2905	Shale & lime	
2957	Shale (ura: - colored) & lime	
2966	Shale	
2968	Sand	
2971	Sandy shale	
2986	Sand & shale	
3002 <sup>1</sup>	Chert & lime T.D.	

We certify that the above  
Log is true and correct to  
the best of our knowledge  
and belief:

Capitt Drilling, Inc.

By

*L. J. Capitt*  
L. J. Capitt

**PLUGGING**  
FILE SEC-19-T-2CR-9E  
BOOK PAGE 143 LINE 40