


STATE OF KANSAS
STATE CORPORATION COMMISSION

WELL PLUGGING RECORD

Give All Information Completely
Make Required Affidavit
Mail or Deliver Report to:
Conservation Division
State Corporation Commission
800 Bitting Building
Wichita, Kansas

Sedgwick County. Sec. 19 Twp. 26 Rge. 2 (E) (W)

Location as "NE/CNW $\frac{1}{4}$ SW $\frac{1}{4}$ " or footage from lines NE/4 SE/4 SE/4
Lease Owner John P. Gaty
Lease Name Tjaden Well No. 4
Office Address 11 Cypress Dr., Wichita, Kansas
Character of Well (completed as Oil, Gas or Dry Hole) Oil well
Date well completed February 12, 1951
Application for plugging filed November 4, 1957
Application for plugging approved November 5, 1957
Plugging commenced February 23, 1958
Plugging completed February 23, 1958
Reason for abandonment of well or producing formation Depleted

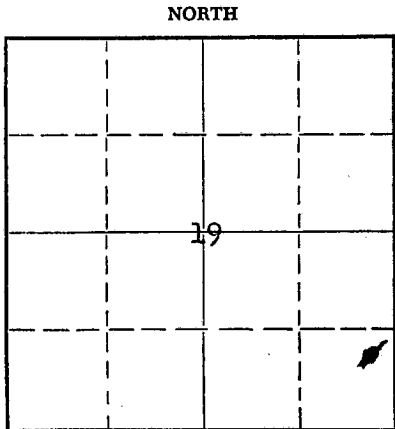

Locate well correctly on above Section Plat

If a producing well is abandoned, date of last production October 1957
Was permission obtained from the Conservation Division or its agents before plugging was commenced? Yes

Name of Conservation Agent who supervised plugging of this well Eugene Gramma, Winfield, Kansas
Producing formation _____ Depth to top _____ Bottom _____ Total Depth of Well 2942 Feet
Show depth and thickness of all water, oil and gas formations.

OIL, GAS OR WATER RECORDS

CASING RECORD

FORMATION	CONTENT	FROM	TO	SIZE	PUT IN	PULLED OUT

Describe in detail the manner in which the well was plugged, indicating where the mud fluid was placed and the method or methods used in introducing it into the hole. If cement or other plugs were used, state the character of same and depth placed, from _____ feet to _____ feet for each plug set.

Put in rock and 5 sacks cement at 2942 T.D.
Mud to 200' of surface
Set solid rock bridge and 15 sacks cement
Mud to 35' of surface
Put in rock bridge and 10 sacks cement.

(If additional description is necessary, use BACK of this sheet)

Name of Plugging Contractor John P. Gaty
Address 11 Cypress Dr., Wichita, Kansas


STATE OF Kansas, COUNTY OF Sedgwick, ss.
Earl Wentworth (employee of owner) or (owner or operator) of the above-described

well, being first duly sworn on oath, says: That I have knowledge of the facts, statements, and matters herein contained and the log of the above-described well as filed and that the same are true and correct. So help me God.

(Signature) Earl Wentworth
734 Pippin Court, Wichita, Kansas
(Address)

SUBSCRIBED AND SWORN TO before me this 12th day of March, 1958

My commission expires December 12, 1959 Notary Public.

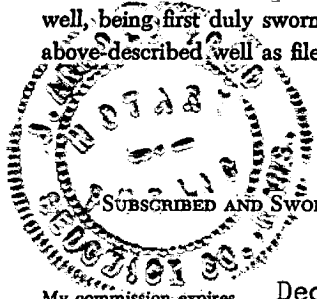

PLUGGING
FILE SEC 19T-26R2E
BOOK PAGE 59 LINE 9

WELL LOG - W. Tjaden #4

OPERATOR: Mr. J. P. Gaty
c/o Beech Aircraft Corp.
Wichita, Kansas

LOCATION: NE SE SE
Section 19-26-2E
Sedgwick County, Kansas

CONTRACTOR: Morrison Drilling Company, Inc.
P. O. Drawer 712
El Dorado, Kansas

PRODUCTION: _____

FARM: Wayne Tjaden Well No. 4

Date Commenced: February 5, 1951
Date Completed: February 12, 1951

Total Depth: 2942 feet - Rotary

From	To	Formation
55	64	Plug and Cement
64	100	Lime & Shale Brks.
100	137	Lime & Shells
137	320	Lime, shells & shale
320	865	Lime & shale strks.
865	925	Shale
925	950	Lime
950	1020	Shale & shells
1020	1026	Red bed
1026	1320	Shale & shells
1320	1520	Shale
1520	1560	Shale & shells
1560	1670	Shale
1670	1850	Lime & shale brks.
1850	1980	Broken lime
1980	2155	Shale
2155	2232	Shale & lime strks.
2232	2245	Lime w/shale strks.
2245	2330	Lime
2330	2495	Lime & shale
2495	2658	Lime
2658	2765	Lime & shale
2765	2824	Shale & lime strks.
2824	2941	Shal3 & shells
2941	2942	Sand
2942		Total Depth

CABLE TOOL LOG

2942-43. Burgess Sand

HFØ -

I hereby certify that the foregoing is a true and correct copy of the well log for the Wayne Tjaden #4 well drilled for Mr. J. P. Gaty and completed February 12, 1951.

MORRISON DRILLING COMPANY, INC.

Signed: C. W. Wilson
C. W. Wilson
Secretary-Treasurer

STATE OF KANSAS)
) SS.
COUNTY OF BUTLER)

SUBSCRIBED AND SWORN TO, Before the undersigned, a Notary Public, in and for the County and State aforesaid this 13th day of February, 1951.

Signed: W.M. Biles
Notary Public

My Commission Expires January 10, 1955.

COPY

NOV 5 1951
CONSERVATION DIVISION
Wichita, Kan.

PLUGGING
FILE SEC 19 T. 26 R2E
BOOK PAGE 59 LINE 9