


STATE OF KANSAS  
STATE CORPORATION COMMISSION

WELL PLUGGING RECORD

Give All Information Completely  
Make Required Affidavit  
Mail or Deliver Report to:  
Conservation Division  
State Corporation Commission  
211 No. Broadway  
Wichita, Kansas

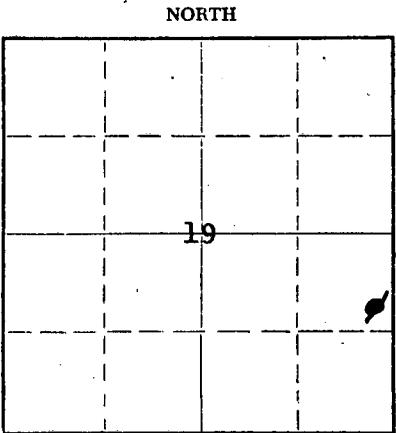

Locate well correctly on above  
Section Plat

Sedgwick County. Sec. 19 Twp. 26 Rge. 2 (E) (W)  
Location as "NE/CNW/SW" or footage from lines SE NE SE  
Lease Owner John P. Gaty  
Lease Name Tjaden Well No. 3  
Office Address 11 Cypress Dr., Wichita, Kansas  
Character of Well (completed as Oil, Gas or Dry Hole) Oil  
Date well completed Dec. 19 50  
Application for plugging filed Nov. 6, 19 58  
Application for plugging approved Nov. 7 19 58  
Plugging commenced Nov. 13 19 58  
Plugging completed Nov. 13 19 58  
Reason for abandonment of well or producing formation Depleted

If a producing well is abandoned, date of last production Sept. 12, 19 58  
Was permission obtained from the Conservation Division or its agents before plugging was commenced? Yes

Name of Conservation Agent who supervised plugging of this well Lee Guthrie  
Producing formation Burgess Depth to top \_\_\_\_\_ Bottom \_\_\_\_\_ Total Depth of Well 2954 1/2 Feet  
Show depth and thickness of all water, oil and gas formations.

OIL, GAS OR WATER RECORDS

CASING RECORD

FORMATION	CONTENT	FROM	TO	SIZE	PUT IN	PULLED OUT

Describe in detail the manner in which the well was plugged, indicating where the mud fluid was placed and the method or methods used in introducing it into the hole. If cement or other plugs were used, state the character of same and depth placed, from \_\_\_\_\_ feet to \_\_\_\_\_ feet for each plug set.

5 Sacks cement in bottom  
Mudded to 150'  
10 Ft. rock bridge with 15 sacks cement at 150'  
Mudded to 20'  
Rock bridge with 5 sacks cement to surface

REC'D  
STATE CORPORATION COMMISSION  
12-1-58  
DEC 1 - 1958  
CONSERVATION DIVISION  
Wichita, Kansas

(If additional description is necessary, use BACK of this sheet)  
Name of Plugging Contractor John P. Gaty  
Address 11 Cypress Dr., Wichita 8, Kansas

STATE OF Kansas, COUNTY OF Sedgwick, ss.  
Earl Wentworth (employee of owner) or (owner or operator) of the above-described well, being first duly sworn on oath, says: That I have knowledge of the facts, statements, and matters herein contained and the log of the above-described well as filed and that the same are true and correct. So help me God.

(Signature) Earl Wentworth  
734 Pippin Court, Wichita, Kansas  
(Address)

SUBSCRIBED AND SWORN TO before me this 25th day of November, 19 58  
December 12, 1959  
My commission expires \_\_\_\_\_  
J. Arnold Howard Notary Public.



PLUGGING  
FILE SEC. 19 T. 26 R. 2E  
BOOK PAGE 143 LINE 27

WELL LOG - Wayne Tjaden #3

OPERATOR: Mr. J. P. Gaty  
c/o Beech Aircraft Corp.  
Wichita, Kansas

LOCATION: SE NE SE  
Section 19-26-2  
Sedgwick County, Kansas

CONTRACTOR: Morrison Drilling Company, Inc.  
P. O. Drawer 712  
El Dorado, Kansas

PRODUCTION: \_\_\_\_\_

Farm: Wayne Tjaden Well No. 3

Date Commenced: December 8, 1950  
Date Completed: December 14, 1950

Total Depth: 2942' - Rotary

From	To	Formation
63	107	Plug & Cement
107	295	Lime & Shale
295	300	Red Bed
300	460	Broken Lime
460	630	Lime & Shale Brks.
630	670	Shale & Lime Strks.
670	780	Lime
780	820	Shale
820	1045	Shale & Lime
1045	1050	Red Bed
1050	1090	Shale
1090	1095	Red Bed
1095	1115	Shale
1115	1121	Red Bed
1121	1260	Shale & Shells
1260	1310	Shale & Lime Strks
1310	1470	Shale
1470	1505	Lime
1505	1545	Shale-sandy
1545	1570	Shale
1570	1620	Lime & Shale
1620	1635	Lime
1635	1785	Shale W/lime Brks.
1785	1860	Lime W/shale Strks.
1860	1955	Lime W/shale Strks.
1955	2225	Shale
2225	2244	Shale & Shells
2244	2305	Lime W/shale Brks.
2305	2365	Shale & Shells
2365	2490	Shale & lime Strks.
2490	2605	Lime
2605	2625	Lime & Shale
2625	2656	Shale & Shells
2656	2685	Lime & Shale Brks.
2685	2793	Shale
2793	2825	Lime & Shale Strks.
2825	2935	Shale & Lime Shells
2935	2942	Shale
2942		Total Depth.

Cable Tool Log

2942 - 2943 Shale X Chert  
2943 - 2952 Shale, White  
2952 - 2954 1/2 Sand

I hereby certify that the foregoing is a true and correct copy of the Well Log for the Wayne Tjaden #3 Well drilled for Mr. J. P. Gaty and Completed December 14, 1950.

MORRISON DRILLING COMPANY, INC.

Signed: C. W. Wilson

C. W. Wilson  
Secretary-Treasurer

STATE OF KANSAS )  
                          ) SS.  
COUNTY OF BUTLER )

**PLUGGING**  
FILE SEC 19 T 26 R 2E  
BOOK PAGE 143 LINE 27

SUBSCRIBED AND SWORN TO, Before the undersigned, a Notary Public, in and for the County and State aforesaid this 27th day of December, 1950.

Signed: Wm. Biles  
Notary Public NOV 7

My Commission Expires January 10, 1951.