

KW
MW
7/2/08

KANSAS CORPORATION COMMISSION
OIL & GAS CONSERVATION DIVISION
WELL PLUGGING APPLICATION
Please TYPE Form and File ONE Copy

Form CP-1
September 2003
This Form must be Typed
Form must be Signed
All blanks must be Filled

API # 15 - 115-20,819-0000 (Identifier Number of this well). This must be listed for wells drilled since 1967; if no API # was issued,

indicate original spud or completion date _____

Well Operator: TE-PE OIL & GAS KCC License #: 5920
(Owner / Company Name) (Operator's)

Address: P.O. BOX 522 City: CANTON

State: KANSAS Zip Code: 67428 Contact Phone: (620) 628 - 4428

Lease: W. SCULLY Well #: 1-10 Sec. 10 Twp. 18 S. R. 01 East West

230' E - NE - NE - SE/4' Spot Location / QQQQ County: MARION

-2310 Feet (in exact footage) From North / South (from nearest outside section corner) Line of Section (Not Lease Line)

100 Feet (in exact footage) From East / West (from nearest outside section corner) Line of Section (Not Lease Line)

Check One: Oil Well Gas Well D&A Cathodic Water Supply Well
 SWD Docket # _____ ENHR Docket # _____ Other: _____

Conductor Casing Size: _____ Set at: _____ Cemented with: _____ Sacks

Surface Casing Size: 8-5/8 Set at: 215 Cemented with: 125 Sacks

Production Casing Size: 5-1/2 Set at: 3271 Cemented with: 325 Sacks

List (ALL) Perforations and Bridgeplug Sets: PERF. 3254-59, 3242-46, 3216-22, CEMENT BRIDGE PLUG @ 3205, PERF. 3109-1/2-3111

Elevation: 1432 (G.L. / K.B.) T.D.: 3269 P.B.T.D.: 3205 Anhydrite Depth: NA
(Stone Corral Formation)

Condition of Well: Good Poor Casing Leak Junk in Hole

Proposed Method of Plugging (attach a separate page if additional space is needed): ACCORDING TO THE RULES AND REGULATIONS OF THE KANSAS CORPORATION COMMISSION

RECEIVED
KANSAS CORPORATION COMMISSION

Is Well Log attached to this application as required? Yes No Is ACO-1 filed? Yes No

JUL 01 2008

If not explain why? _____
CONSERVATION DIVISION
WICHITA, KS

Plugging of this Well will be done in accordance with K.S.A. 55-101 et. seq. and the Rules and Regulations of the State Corporation Commission.

List Name of Company Representative authorized to be in charge of plugging operations: TERRY P BANDY

TE-PE OIL & GAS Phone: (620) 628 - 4428

Address: P.O. BOX 522 City / State: CANTON, KANSAS 67428

Plugging Contractor: QUALITY WELL SERVICE KCC License #: 31925
(Company Name) (Contractor's)

Address: 190 US 56 HWY, ELLINWOOD, KS 67526 Phone: (620) 727 - 3410

Proposed Date and Hour of Plugging (if known?): JULY 2, 2008

Payment of the Plugging Fee (K.A.R. 82-3-118) will be guaranteed by Operator or Agent
Date: 06/30/2008 Authorized Operator / Agent: Cynthia G. Beweke
(Signature)

Mail to: KCC - Conservation Division, 130 S. Market - Room 2078, Wichita, Kansas 67202

RECEIVED
KANSAS CORPORATION COMMISSION

JUL 01 2008

CONSERVATION DIVISION
WICHITA, KS

GREAT GUNS

Gamma Ray Neutron

WELL LOG NO. _____

COMPANY R. J. WALKER OIL CO. INC.

WELL 1-10- W. SCULLY

FIELD _____

COUNTY MARION STATE KANSAS

Location: 330' FNL + 100' FEL SE/4

Other Services:
Perf 4/87
3254-3269

Sec. 10 Twp. 18 Rge. 1E

Permanent Datum G.L. Elev. 1425 Elev.: K.B. 1432

Measured From K.B. 7 Ft. Above Perm. Datum D.F. 1431

Logging Measured From K.B. G.L. 1425

Date 12-4-81

Run No. TWO

Core Log GRN

Depth—Driller 3271

Depth—Logger 3267

Bottom Logged Interval 3266

Top Logged Interval 0

Fluid In Hole FRESH WATER

Salinity, PPM CL N/A

Density N/A

Temperature 400

Core Rec. Temp., Deg F. 104

Operating Rig Time 1 Hr.



Log No. & Location 41 DERRY

Recorded By REIN

Checked By _____

FIELD PRINT

BORE-HOLE RECORD				CASING RECORD			
Log No.	Bit Size	From	To	Size	Wgt.	From	To
127/4	0	0	215	8 3/8		0	215
77/8	2 1/2	215	3271	5 1/2		0	3271

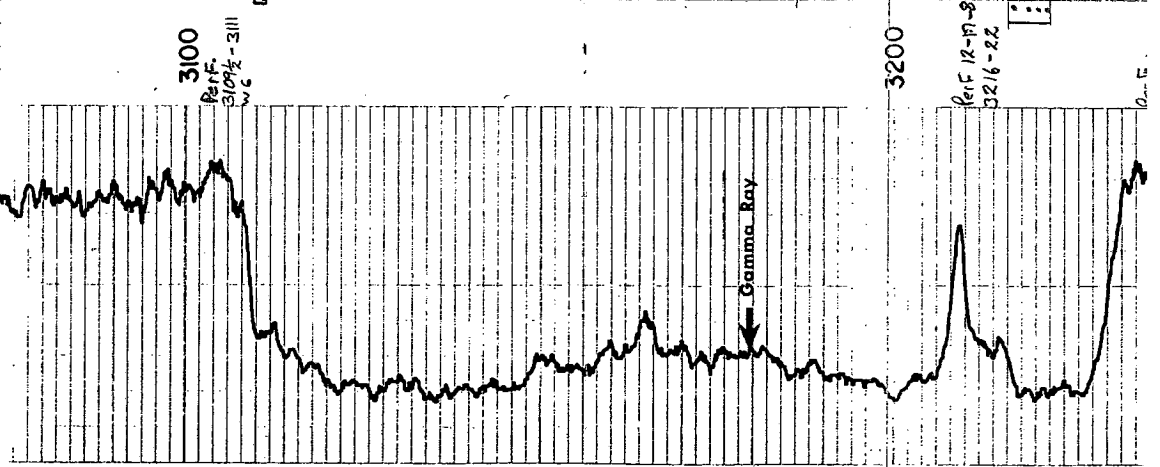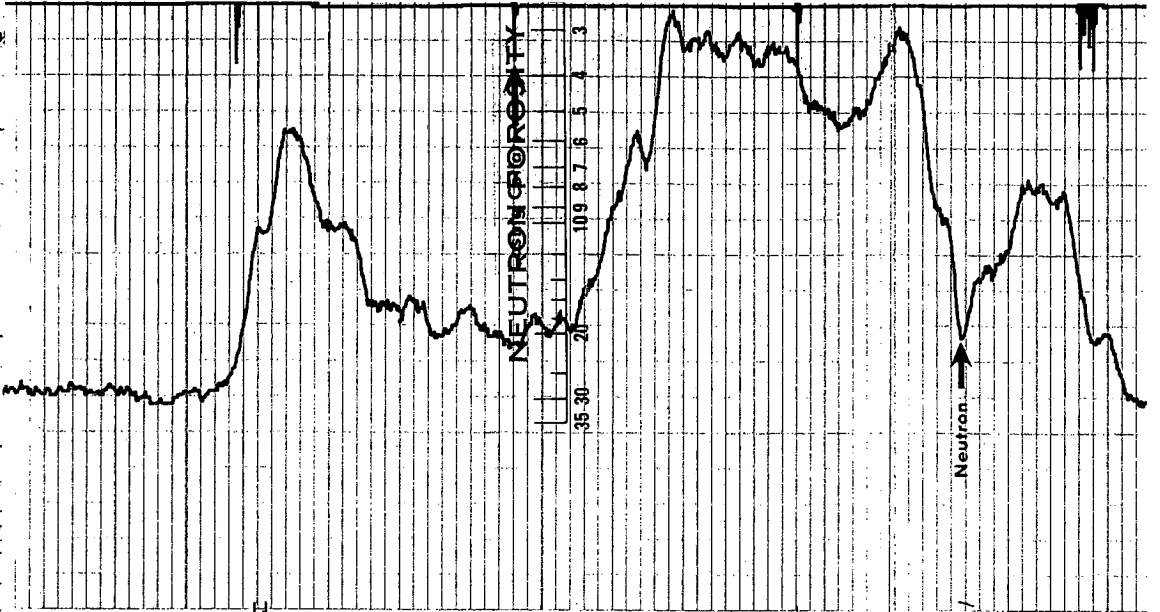



CORPORATION COMMISSION

Kathleen Sebelius, Governor Thomas E. Wright, Chairman Michael C. Moffet, Commissioner Joseph F. Harkins, Commissioner

NOTICE OF RECEIPT OF WELL PLUGGING APPLICATION (CP-1)

BANDY, TERRY P. DBA TE-PE OIL & GAS
PO BOX 522
CANTON, KS 67428-0522

July 02, 2008

Re: W SCULLY #1-10
API 15-115-20819-00-00
10-18S-1E, 2310 FSL 100 FEL,
MARION COUNTY, KANSAS

Dear Operator:

This letter is to notify you that the Conservation Division has received your plugging proposal, form CP-1, for the above well and has reviewed the proposal for completeness. The central office will now forward your CP-1 to the district office listed below for review of the proposed plugging method. **Please contact the district office for approval of your proposed plugging method at least five (5) days before plugging the well, pursuant to K.A.R. 82-3-113(b). If a workover pit will be used during the plugging of the well it must be permitted. A CDP-1 form must be filed and approved prior to the use of the pit in accordance with K.A.R. 82-3-600.**

The Conservation Division's review of form CP-1, either in the central or district office, does not include an inquiry into well ownership or the filing operator's legal right to plug the well. This notice in no way constitutes authorization to plug the above well by persons not having legal rights of ownership or interest in the well.

This notice is void after December 29, 2008. The CP-1 filing does not bring the above well into compliance with K.A.R. 82-3-111 with regard to the Commission's temporary abandonment requirements.

Sincerely,

Steve Bond
Production Department Supervisor

District: #2
3450 N. Rock Road, Suite 601
Wichita, KS 67226
(316) 630-4000