

KCC
Mun
7/7/08

KANSAS CORPORATION COMMISSION
OIL & GAS CONSERVATION DIVISION
WELL PLUGGING APPLICATION
Please TYPE Form and File ONE Copy

Form CP-1
September 2003
This Form must be Typed
Form must be Signed
All blanks must be Filled

API # 15 - 015-22,150 - 0000 (Identifier Number of this well). This must be listed for wells drilled since 1967; if no API # was issued,

indicate original spud or completion date 2-10-83 9/21/82

Well Operator: TE-PE OIL & GAS KCC License #: 5920

Address: P.O. BOX 522 City: CANTON

State: KANSAS Zip Code: 67428 Contact Phone: (620) 628 - 4428

Lease: REED Well #: 3 Sec. 32 Twp. 25 S. R. 03 East West

SW SE4 NE Spot Location / QQQQ County: BUTLER

2970 Feet (in exact footage) From North / South (from nearest outside section corner) Line of Section (Not Lease Line)

990 Feet (in exact footage) From East / West (from nearest outside section corner) Line of Section (Not Lease Line)

Check One: Oil Well Gas Well D&A Cathodic Water Supply Well
 SWD Docket # _____ ENHR Docket # _____ Other: _____

Conductor Casing Size: _____ Set at: _____ Cemented with: _____ Sacks

Surface Casing Size: 8-5/8 Set at: 211 Cemented with: 150 Sacks

Production Casing Size: 4-1/2 Set at: 2836 Cemented with: 75 Sacks

List (ALL) Perforations and Bridgeplug Sets: PERF 2740-46

Elevation: 1319 (G.L. / K.B.) T.D.: 2838 P.B.T.D.: 2776 Anhydrite Depth: NA
(Stone Corral Formation)

Condition of Well: Good Poor Casing Leak Junk in Hole

Proposed Method of Plugging (attach a separate page if additional space is needed): ACCORDING TO THE RULES AND REGULATIONS OF THE KANSAS CORPORATION COMMISSION

RECEIVED
KANSAS CORPORATION COMMISSION

Is Well Log attached to this application as required? Yes No Is ACO-1 filed? Yes No

JUL 03 2008

If not explain why? _____
CONSERVATION DIVISION
WICHITA, KS

Plugging of this Well will be done in accordance with K.S.A. 55-101 et. seq. and the Rules and Regulations of the State Corporation Commission.

List Name of Company Representative authorized to be in charge of plugging operations: TERRY P BANDY

TE-PE OIL & GAS Phone: (620) 628 - 4428

Address: P.O. BOX 522 City / State: CANTON, KANSAS 67428

Plugging Contractor: QUALITY WELL SERVICE KCC License #: 31925

Address: 190 US 56 HWY, ELLINWOOD, KS 67526 Phone: (620) 727 - 3410


Proposed Date and Hour of Plugging (if known?): JULY 8, 2008

Payment of the Plugging Fee (K.A.R. 82-3-118) will be guaranteed by Operator or Agent

Date: 07/02/2008 Authorized Operator / Agent: Terry Bandy (Signature)


Mail to: KCC - Conservation Division, 130 S. Market - Room 2078, Wichita, Kansas 67202

DYNA-LOG, INC.

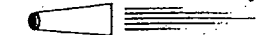

Complete Cased Hole Services

FILING NO.	COMPANY _____							
	WELL <u>Reed #3</u>							
	FIELD _____							
COUNTY <u>BUTLER</u>		STATE <u>KANSAS</u>						
LOCATION <u>SW-SE-1/4</u>		OTHER SERVICES _____						
SEC <u>32</u>	TWSP <u>25s</u>	RGE <u>3E</u>						
PERMANENT DATUM: <u>GL</u>	ELEV. <u>1314</u>	ELEVATION KB <u>1319</u>						
LOG MEASURED FROM: <u>KSR</u>	<u>5</u> FT. ABOVE PERM. DATUM	OF <u>1314</u>						
DRILLING MEASURED FROM: _____								
DATE <u>2004</u>								
RUN NO.								
TYPE LOG								
DEPTH - DRILLER								
DEPTH - LOGGER								
BOTTOM LOGGED INTERVAL								
TOP LOGGED INTERVAL								
TYPE FLUID IN HOLE								
TOOL MODEL NO.								
SOURCE MODEL NO.								
SOURCE STRENGTH								
SOURCE SERIAL NO.								
OPERATING RIG TIME								
RECORDED BY:								
WITNESSED BY:								
AEC LICENSE NO.								
RUN NO.	BORE-HOLE RECORD				CASING RECORD			
	BIT	FROM	TO	SIZE	WGT	FROM	TO	
				<u>8 5/8</u>		<u>0</u>	<u>211'</u>	
				<u>4 1/2</u>		<u>0</u>	<u>2836'</u>	

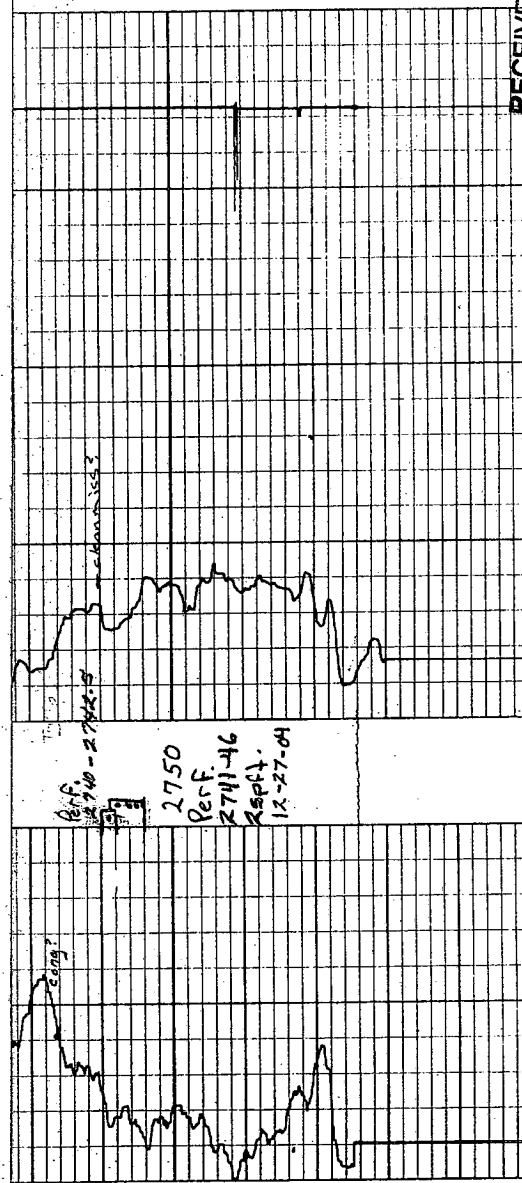

RECEIVED
KANSAS CORPORATION COMMISSION

JUL 03 2008

CONSERVATION DIVISION
WICHITA, KS

12-27-04 Perf. 2776
12-28-04 acidize these phos. 600gal 15% and anal. test
12-29-04 soil pump clean. Run in



CORPORATION COMMISSION

Kathleen Sebelius, Governor Thomas E. Wright, Chairman Michael C. Moffet, Commissioner Joseph F. Harkins, Commissioner

NOTICE OF RECEIPT OF WELL PLUGGING APPLICATION (CP-1)

BANDY, TERRY P. DBA TE-PE OIL & GAS
PO BOX 522
CANTON, KS 67428-0522

July 07, 2008

Re: REED #3
API 15-015-22150-00-00
32-25S-3E, 2970 FSL 990 FEL
BUTLER COUNTY, KANSAS

Dear Operator:

This letter is to notify you that the Conservation Division has received your plugging proposal, form CP-1, for the above well and has reviewed the proposal for completeness. The central office will now forward your CP-1 to the district office listed below for review of the proposed plugging method. **Please contact the district office for approval of your proposed plugging method at least five (5) days before plugging the well, pursuant to K.A.R. 82-3-113(b). If a workover pit will be used during the plugging of the well it must be permitted. A CDP-1 form must be filed and approved prior to the use of the pit in accordance with K.A.R. 82-3-600.**

The Conservation Division's review of form CP-1, either in the central or district office, does not include an inquiry into well ownership or the filing operator's legal right to plug the well. This notice in no way constitutes authorization to plug the above well by persons not having legal rights of ownership or interest in the well.

This notice is void after January 3, 2009. The CP-1 filing does not bring the above well into compliance with K.A.R. 82-3-111 with regard to the Commission's temporary abandonment requirements.

Sincerely,

Steve Bond

Production Department Supervisor

District: #2
3450 N. Rock Road, Suite 601
Wichita, KS 67226
(316) 630-4000