


13-141-00058-00-00

STATE OF KANSAS
STATE CORPORATION COMMISSION

Give All Information Completely
Make Required Affidavit
Mail or Deliver Report to:
Conservation Division
State Corporation Commission
800 Bitting Building
Wichita, Kansas

WELL PLUGGING RECORD

NORTH

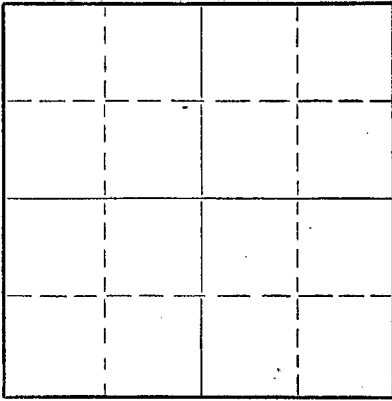

Locate well correctly on above
Section Plat

Osborne County. Sec. 16 Twp. 9S Rge. 15W (E) x (W)
Location as "NE/CNW%SW%" or footage from lines SE SE NE

Lease Owner Beach & Talbot

Lease Name Tatkenhorst Well No. 1

Office Address First National Bldg., Tulsa, Oklahoma

Character of Well (completed as Oil, Gas or Dry Hole) Dry hole

Date well completed 8-25 19 52

Application for plugging filed 8-25 19 52

Application for plugging approved 8-25 19 52

Plugging commenced 4:00 p.m. 8-25 19 52

Plugging completed 4:00 p.m. 8-26 19 52

Reason for abandonment of well or producing formation

Commercial quantity of oil not found

If a producing well is abandoned, date of last production 19

Was permission obtained from the Conservation Division or its agents before plugging was commenced? yes

Name of Conservation Agent who supervised plugging of this well Eldon Petty

Producing formation _____ Depth to top _____ Bottom _____ Total Depth of Well 3964 Feet

Show depth and thickness of all water, oil and gas formations.

OIL, GAS OR WATER RECORDS

CASING RECORD

FORMATION	CONTENT	FROM	TO	SIZE	PUT IN	PULLED OUT
				8 5/8		none

Describe in detail the manner in which the well was plugged, indicating where the mud fluid was placed and the method or methods used in introducing it into the hole. If cement or other plugs were used, state the character of same and depth placed, from _____ feet to _____ feet for each plug set.

Filled hole with heavy mud from 3964' to 180'. Set Halliburton plug with 15 sacks of cement 180'-135'. Filled hole with heavy mud from 135'-35'. Set Halliburton plug - 1/2 sack hulls and 10 sacks cement.

RECEIVED
 STATE CORPORATION COMMISSION
 AUG 29 1952
 CONSERVATION DIVISION
 Wichita, Kansas

Name of Plugging Contractor Deek Drilling, Inc. 8-29-52
 Address 1006 Central Bldg., Wichita, Kansas

STATE OF KANSAS, COUNTY OF SEDGWICK ss.
Clinton Engstrand, agent for (employee of owner) of the above-described well, being first duly sworn on oath, says: That I have knowledge of the facts, statements, and matters herein contained and the log of the above-described well as filed and that the same are true and correct. So help me God.

(Signature) Clinton Engstrand
1006 Central Bldg., Wichita, Kansas
(Address)

SUBSCRIBED AND SWORN TO before me this 28 day of August, 19 52
Medallu Boyer
Notary Public.

My commission expires 10-29-55

24-2675-S 2-52-20M

PLUGGING
FILE SEC 16 T 9 R 15W
BOOK PAGE 40 LINE 32

BEACH & TALBOT
TATKENHORST #1

SE SE NE Sec. 16-98-15W
Osborne County, Kansas

Casing

8 5/8" Set @ 193'

Comm: 8-10-52
Comp: 8-25-52
Total Depth: 3964'

Cement

115 Sacks

<u>FORMATION</u>	<u>DEPTH</u>
Surface soil	0 - 193
Shale and shells	193 - 521
Shale and shells	521 - 1090
Shale & shells	1090 - 1300
Anhydrite lime	1300 - 1336
Shale and shells	1336 - 1362
Shale and broken lime	1362 - 1650
Lime and shale	1650 - 1850
Lime	1850 - 1933
Lime and shale	1933 - 2075
Lime and shale	2075 - 3148
Lime	3148 - 3198
Lime and shale	3198 - 3270
Lime	3270 - 3497
Lime and shale	3497 - 3687
Lime, shale and conglomerate	3687 - 3725
Cherty conglomerate	3725 - 3765
Conglomerate	3765 - 3795
Lime and shale	3795 - 3836
Lime, shale & chert	3836 - 3861
Lime	3861 - 3895
Lime and shale	3895 - 3935
Lime and shale	3935 - 3964 TD

STATE OF KANSAS)
) SS
SEDGWICK COUNTY)

I hereby certify that the above information is true and correct to the best of my knowledge.

[Handwritten Signature]

Subscribed and sworn to before me this 28th day of August, 1952.

[Handwritten Signature]
Notary Public

My Commission Expires: 10-29-55

PLUGGING
FILE SEC 16 T 9 R 15
BOOK PAGE 40 LINE 32

10-11-52
OCT 11 1952
CONSERVATION DIVISION
Wichita, Kansas