

STATE OF KANSAS
STATE CORPORATION COMMISSION


Give All Information Completely
Make Required Affidavit
Mail or Deliver Report to:
Conservation Division
State Corporation Commission
800 Bitting Building
Wichita, Kansas

WELL PLUGGING RECORD

Osborne County, Sec. 22 Twp. 9 Rge. ~~16~~ 15 (W)
Location as "NE/CNW/SW" or footage from lines SW/SW/NW

Lease Owner: Sohio Petroleum Company
Lease Name: Kreft Well No. 1
Office Address: Russell, Kansas

Character of Well (completed as Oil, Gas or Dry Hole) Dry
Date well completed 5-3 19 53
Application for plugging filed 5-4 19 53
Application for plugging approved 5-7 19 53
Plugging commenced 5-3 19 53
Plugging completed 5-3 19 53
Reason for abandonment of well or producing formation Dry

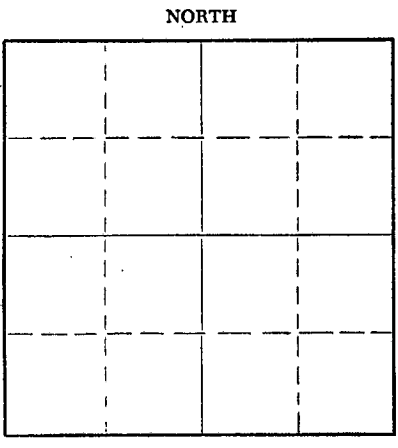

Locate well correctly on above Section Plat

If a producing well is abandoned, date of last production 19
Was permission obtained from the Conservation Division or its agents before plugging was commenced? Yes

Name of Conservation Agent who supervised plugging of this well
Producing formation Depth to top Bottom Total Depth of Well 3928 Feet
Show depth and thickness of all water, oil and gas formations.

OIL, GAS OR WATER RECORDS

CASING RECORD

FORMATION	CONTENT	FROM	TO	SIZE	PUT IN	PULLED OUT
				8-5/8"	326'	None

Describe in detail the manner in which the well was plugged, indicating where the mud fluid was placed and the method or methods used in introducing it into the hole. If cement or other plugs were used, state the character of same and depth placed, from feet to feet for each plug set.

3928' to 300' Heavy Mud
300' to 35' Rubber Plug & 10 Sacks Cement & Heavy Mud
35' to Cellar - 7 Sacks Cement

VED
MAY 14 1953
5-14-1953
CONSERVATION DIVISION
WICHITA, KANSAS

(If additional description is necessary, use BACK of this sheet)
Name of Plugging Contractor: Reserve Drilling Company
Address: Wichita, Kansas


STATE OF KANSAS, COUNTY OF RUSSELL, ss.
J. H. BOND (employee of owner)

well, being first duly sworn on oath, says: That I have knowledge of the facts, statements, and matters herein contained and the log of the above-described well as filed and that the same are true and correct. So help me God.

(Signature) J. H. Bond
(Address)

SUBSCRIBED AND SWORN TO before me this 13 day of May, 1953
Russell Miller
Notary Public.

My commission expires July 2, 1953

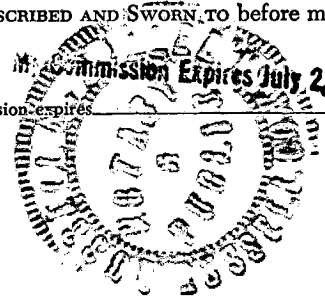

PLUGGING
FILE SEC 22 T 9 R 15W
BOOK PAGE 99 LINE 14

15-141-00043-00-00

WELL LOG

Sohio Petroleum Co.

Kreft No. 1

SW SW NW 22-9S-15W
Osborne County, Kansas

Comm: 4-16-53

Comp: 5-3-53

Casing: 8-5/8" 324' w/200 Sax

<u>Formation</u>	<u>Depth</u>
Surface	324
Shale, shells and sand	1005
Shale and shells	1259
Anhydrite	1293
Shale and shells	2015
Lime and shale	3373
Lime	3414
Lime and shale	3695
Lime, shale and chert	3777
Lime and chert	3796
Viola Lime	3837
Lime and shale	3881
Arbuckle	3928
T. D.	3928

STATE OF KANSAS

SS:

COUNTY OF SEDGWICK

L. C. Hay, of lawful age, deposes and states that the above formations and depths are correct as shown by the daily drilling log of the Kreft No. 1 in the SW SW NW 22-9-15W, Osborne County, Kansas.

L. C. Hay

Subscribed and sworn to before me this 11th day of May, 1953.

Walter P. ...

Notary Public

My commission expires Nov. 13, 1956

5-14-1953

PLUGGING

FILE SEC 22-9-D-154

BOOK PAGE 99 LINE 143