

STATE OF KANSAS
STATE CORPORATION COMMISSION

WELL PLUGGING RECORD

OR

FORMATION PLUGGING RECORD

Strike out upper line
when reporting plugging
off formations.

Give All Information Completely
Make Required Affidavit
Mail or Deliver Report to:
Conservation Division
State Corporation Commission
800 Bitting Building
Wichita, Kansas

Rooks County, Sec. 2 Twp. 9 Rge. (E) 16 (W)

Location as "NE 1/4 NW 1/4 SW 1/4" or footage from lines CW 1/2 NW NE

Lease Owner Broadview Oil Company and Helmerich & Payne, Inc.

Lease Name Baxter "C" Well No. 2

Office Address 415 Philtower, Tulsa, Oklahoma.

Character of Well (completed as Oil, Gas or Dry Hole) Dry

Date, well completed 6-9-1941

Application for plugging filed 7-1-1941

Application for plugging approved 7-1-1941


Plugging Commenced 7-3-1941

Plugging Completed 7-4-1941

Reason for abandonment of well or producing formation Dry

If a producing well is abandoned, date of last production None 19

Was permission obtained from the Conservation Division or its agents before plugging was commenced? Yes

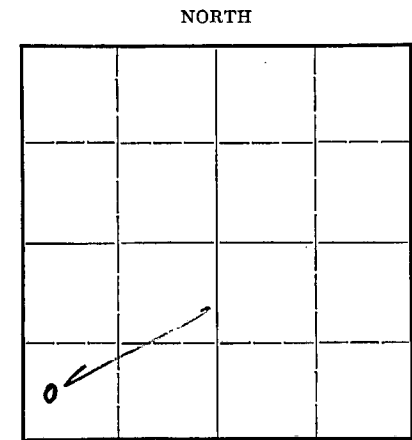

Locate well correctly on above
Section Plat

Name of Conservation Agent who supervised plugging of this well C. T. Alexander

Producing formation None Depth to top Bottom Total Depth of Well 3290 Feet

Show depth and thickness of all water, oil and gas formations.

OIL, GAS OR WATER RECORDS

CASING RECORD


Formation	Content	From	To	Size	Put In	Pulled Out
				8 5/8"	102	
				5 1/2"	3221	2698

Describe in detail the manner in which the well was plugged, indicating where the mud fluid was placed and the method or methods used in introducing it into the hole. If cement or other plugs were used, state the character of same and depth placed, from feet to feet for each plug set.

Filled with mud from 3290' to 3221'. Dumped cement and filled from bridge at 3221 to 3200'. Filled with mud to 2900'. Ripped casing at 2800' and not free. Got free at 2698'. Pulled casing and mudded hole as pulled. Mudded to 250 ft. Bridged at 250 ft. Dumped 8 sacks cement and filled from 250 ft. to 230 ft. Mudded to 18 ft. Dumped cement and filled to 8 ft.

Pd.
7/11/41
Na

FILE 29-166W
BOOK 145 LINE 24

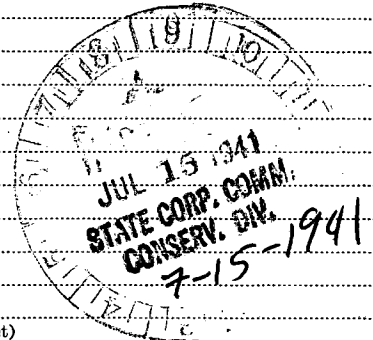

(If additional description is necessary, use BACK of this sheet)

Correspondence regarding this well should be addressed to Helmerich & Payne, Inc.
Address 415 Philtower Bldg., Tulsa, Oklahoma.

STATE OF Oklahoma, COUNTY OF Tulsa, ss.

J. C. M. Copeland (employee of owner) or (owner or operator) of the above-described well,

being first duly sworn on oath, says: That I have knowledge of the facts, statements, and matters herein contained and the log of the above-described well as filed and that the same are true and correct. So help me God.

(Signature) J. C. M. Copeland
415 Philtower (Address)

SUBSCRIBED AND SWORN to before me this 11th day of July 1941

(Signature) Alice Huffman
Notary Public.

My commission expires July 2nd, 1943.



15-163-02766-00-00

Baxter "C" #8
NE 1/4 of Section 2-9S-16W
Rooks County, Kansas.
Broadview Oil Company
and
Helmerich & Payne, Inc.

Commenced: May 25, 1941.
Completed: June 9, 1941.

Surface shale and shells	0	100
Shale and sand	100	900
Shale and salt	900	1000
Shale	1000	1310
Anhydrite	1310	1350
Shale and shells	1350	1750
Shale and lime	1750	2225
Broken lime	2225	2552
Shale and lime	2552	2640
Shale	2640	2915
Shale and lime	2915	2970
Lime	2970	3290
TOTAL DEPTH		3290

CASING RECORD

3-5/8" O. D. Casing set at 102' and cemented with 65 sacks of cement.

5-1/2" O. D. Casing set at 3231' and cemented with 125 sacks of cement.

STATE OF OKLAHOMA)

COUNTY OF TULSA)

I hereby affirm that the above and foregoing is a true and correct copy of the log of the Baxter "C" well #8, located in the Northeast Quarter of Section 2, Township 9 South, Range 16 West, Rooks County, Kansas.

HELMERICH & PAYNE, INC.

BY William Broadhead
Treasurer

Subscribed and sworn to before me, a Notary Public, this 16th. day of June, 1941.

Lee Griffin
Notary Public

My commission expires July 22, 1943.



21-29-16W
145-24

JUL 15 1941
STATE CORP. COM.
CONSERV. DIV.
7-15-1941