


STATE OF KANSAS  
STATE CORPORATION COMMISSION

Give All Information Completely  
Make Required Affidavit  
Mail or Deliver Report to:  
Conservation Division  
State Corporation Commission  
212 No. Market  
Wichita, Kansas

WELL PLUGGING RECORD

NORTH

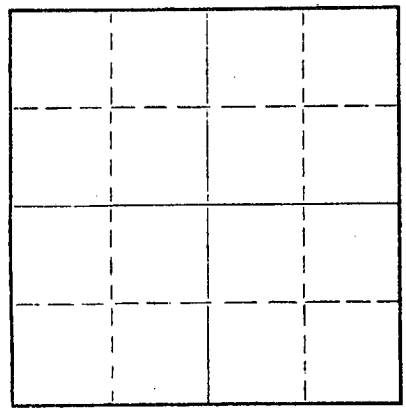

Locate well correctly on above Section Plat

Rooks \_\_\_\_\_ County. Sec. 2 Twp. 9S Rge. 16W (~~EX~~) (W)  
Location as "NE/CNW/SW" or footage from lines C W/2 SW NE  
Lease Owner Hedrick & Goering & Hedrick  
Lease Name McFadden Well No. 4 (Twin)  
Office Address Box 296 Newton, Kansas  
Character of Well (completed as Oil, Gas or Dry Hole) \_\_\_\_\_  
Date well completed \_\_\_\_\_ 19\_\_\_\_  
Application for plugging filed \_\_\_\_\_ 19\_\_\_\_  
Application for plugging approved \_\_\_\_\_ 19\_\_\_\_  
Plugging commenced September 1, 19 60  
Plugging completed September 1, 19 60  
Reason for abandonment of well or producing formation \_\_\_\_\_

If a producing well is abandoned, date of last production \_\_\_\_\_ 19\_\_\_\_  
Was permission obtained from the Conservation Division or its agents before plugging was commenced? YES

Name of Conservation Agent who supervised plugging of this well Eldon Petty  
Producing formation \_\_\_\_\_ Depth to top \_\_\_\_\_ Bottom \_\_\_\_\_ Total Depth of Well 1320 Feet  
Show depth and thickness of all water, oil and gas formations.

OIL, GAS OR WATER RECORDS

CASING RECORD

FORMATION	CONTENT	FROM	TO	PUT IN	PULLED OUT

RECEIVED  
STATE CORPORATION COMMISSION  
AUG 20 1968  
CONSERVATION DIVISION  
Wichita, Kansas  
8-20-1968

Describe in detail the manner in which the well was plugged, indicating where the mud fluid was placed and the method or methods used in introducing it into the hole. If cement or other plugs were used, state the character of same and depth placed, from \_\_\_\_\_ feet to \_\_\_\_\_ feet for each plug set.

Lost hole on attempted washdown of old well know as Baxter C-1

8 5/8" 100' circulated with cement.  
Circulated hole with heavy mud, set cementing plug at 550' displaced 15 sacks cement through drill pipe at 550', heavy mud to 165', set cementing plug and displaced 15 sacks cement through drill pipe, heavy mud to 40'-set plug, 1 sack hulls and filled to bottom of cellar with cement.

(If additional description is necessary, use BACK of this sheet)

Name of Plugging Contractor Shields Drilling Company  
Address Russell, Kansas

STATE OF KANSAS, COUNTY OF HARVEY, ss.  
Albert A. Goering (employee of owner) or (owner or operator) of the above-described well, being first duly sworn on oath, says: That I have knowledge of the facts, statements, and matters herein contained and the log of the above-described well as filed and that the same are true and correct. So help me God.

(Signature) X Albert A. Goering  
Box 366 Newton, Kansas  
(Address)

SUBSCRIBED AND SWORN to before me this 19th day of August, 1968



Evelyn Dirks  
Notary Public.