

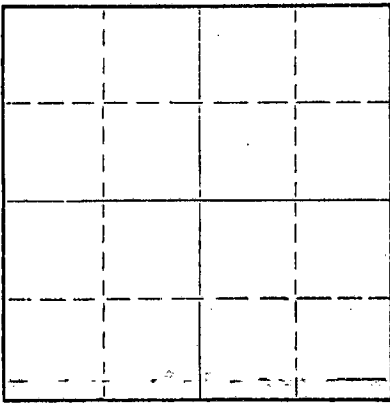
STATE OF KANSAS
STATE CORPORATION COMMISSION

Form CP-4

Give All Information Completely
Make Required Affidavit
Mail or Deliver Report to:
Conservation Division
State Corporation Commission
211 No. Broadway
Wichita, Kansas

WELL PLUGGING RECORD

NORTH

Locate well correctly on above
Section PlatRooks _____ County. Sec. 2 Twp. 9 Rge. 16W (X) (W)Location as "NE/CNW/SW" or footage from lines CNL SW NWLease Owner Broadview Oil CompanyLease Name Baxter Well No. A-4Office Address Broadview Hotel Emporia, Kansas attemptedCharacter of Well (completed as Oil, Gas or Dry Hole) DRY HOLE-washdown -lost hole

Date well completed _____ 19____

Application for plugging filed _____ 19____

Application for plugging approved _____ 19____

Plugging commenced _____ 19____

Plugging completed July 23, 19 60

Reason for abandonment of well or producing formation _____

If a producing well is abandoned, date of last production _____ 19____

Was permission obtained from the Conservation Division or its agents before plugging was commenced? YesName of Conservation Agent who supervised plugging of this well Eldon PettyProducing formation _____ Depth to top _____ Bottom _____ Total Depth of Well original T. D. 3240' Feet

Show depth and thickness of all water, oil and gas formations.

Lost Hole @ 2380'

OIL, GAS OR WATER RECORDS

CASING RECORD

FORMATION	CONTENT	FROM	TO	SIZE	PUT IN	PULLED OUT

Describe in detail the manner in which the well was plugged, indicating where the mud fluid was placed and the method or methods used in introducing it into the hole. If cement or other plugs were used, state the character of same and depth placed, from _____ feet to _____ feet for each plug set.

8 5/8" 99' circulated with cement.Circulated hole with heavy mud, set plug at 540' with 20 sacks cement, heavy mud to 180', set plug and 20 sacks cement, heavy mud to 40', set plug, huffs and filled to bottom cellar with cementRECEIVED
STATE CORPORATION COMMISSION

SEP 19 1963

9-19-1963
CONSERVATION DIVISION
Wichita, Kansas

(If additional description is necessary, use BACK of this sheet)

Name of Plugging Contractor _____

Shields Drilling Co.Address Shields Bldg. Russell, Kansas

STATE OF _____, COUNTY OF _____, ss.

_____, (employee of owner) or (owner or operator) of the above-described well, being first duly sworn on oath, says: That I have knowledge of the facts, statements, and matters herein contained and the log of the above-described well as filed and that the same are true and correct. So help me God.

(Signature) _____

Elmer W. Siedhoff, Sec. - Tres.

(Address) _____

SUBSCRIBED AND SWORN to before me this 18th day of September, 19 63My commission expires March 31-1966

Notary Public.



The Broadview Oil Company

Broadview Hotel

Emporia, Kansas

BROADVIEW OIL CO. & HELMERICH & PAYNE, Inc.

Sec 2 T. 9 R. 16W

CNL SW NW

Rooks County, Kansas

Baxter No. 4

Total depth 3193

Comm. 5-4-41 Comp. 5-22-41

Shot or Treated

Contractor

Issued 6-21-41

Casing:

8 5/8 " surface casing 99' cemented

5 1/2" 3144 cemented

Figures indicate bottom of formations

surface clay 20

Shale and shells	70
shale	250
shale sand & shells	1000
shale and shells	1265
anhydrite	1310
red bed and shells	1570
shale and lime	2155
lime	2245
shale and lime	2555
shale	2650
lime and shale	2720
shale	2770
lime	2860
shale and lime	3139
lime	3147
lime hard	3149
lime med	3156
lime hard	3162
lime med	3167
lime hard	3175
lime wh hd	3177
lime hd	3180
shale	3182
lime hard	3191
shale	3193

first oil show 3147

filled up 250' when drilling 3149-3158

RECEIVED
STATE CORPORATION COMMISSION

SEP 26 1960
9-26-1960
CONSERVATION DIVISION
Wichita, Kansas

BROADVIEW OIL CO.
Broadview Oil Co.

15-163-19187-00-01

Baxter A (4)
CNL SW NW 2-9-16W
Rooks County
August 22, 1960

Plugging record

TD 2380
Heavy mud back to 540
Plugged
Dumped 20 sacks of Cement through drill stem
Heavy mud to 180
Plugged
Dumped 20 sacks of Cement through drill stem
Heavy mud to 40
Dumped $\frac{1}{4}$ sack of hulls
Plugged
Dumped 10 sacks of Cement

Plugged by Shields Drilling Co.
Russell, Kansas

RECEIVED
STATE CORPORATION COMMISSION
SEP 26 1960
9-26-1960
CONSERVATION DIVISION
Wichita, Kansas