


WELL PLUGGING RECORD

Give All Information Completely
Make Required Affidavit
Mail or Deliver Report to:
Conservation Division
State Corporation Commission
800 Bittling Building
Wichita, Kansas

NORTH

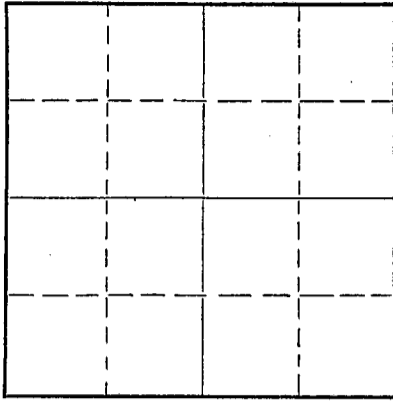

Locate well correctly on above Section Flat

Sherman County. Sec. 11 Twp. 8S Rge. 40 (E) W (W)
Location as "NE/CNW $\frac{1}{4}$ SW $\frac{1}{4}$ " or footage from lines SE SE NE
Lease Owner Kingwood Oil Company
Lease Name G. W. Rauckmann Well No. 1
Office Address Cravens Building, Oklahoma City, Oklahoma
Character of Well (completed as Oil, Gas or Dry Hole) Dry Hole
Date well completed 8-1-52 19
Application for plugging filed 4-9-53 19
Application for plugging approved 4-10-53 19
Plugging commenced 5-29-53 19
Plugging completed 5-31-53 19
Reason for abandonment of well or producing formation dry hole
If a producing well is abandoned, date of last production 19
Was permission obtained from the Conservation Division or its agents before plugging was commenced? YES

Name of Conservation Agent who supervised plugging of this well Mr. Eldon Petty
Producing formation Dry Depth to top Bottom Total Depth of Well 5573 Feet
Show depth and thickness of all water, oil and gas formations.

OIL, GAS OR WATER RECORDS

CASING RECORD

| Formation | Content | From | To | Size | Put In | Pulled Out |
|-----------|---------|------|----|---------|--------|------------|
| | | | | 10 3/4" | 307 | 0 |
| | | | | 5 1/2" | 4688 | 3700 |
| | | | | | | |
| | | | | | | |
| | | | | | | |
| | | | | | | |
| | | | | | | |
| | | | | | | |
| | | | | | | |

Describe in detail the manner in which the well was plugged, indicating where the mud fluid was placed and the method or methods used in introducing it into the hole. If cement or other plugs were used, state the character of same and depth placed, from feet to feet for each plug set.

During the time well was being tested, it was plugged back with mud 5573-4590'; Baker plug at 4590; plugged back with mud, 4590-4395'; Baker plug at 4395'; plugged back with mud, 4395-4170'; Baker plug at 4170'.

This job: 5 sacks of cement, 4170-4130'; pumped in mud 4130-307'; 15 sacks of cement, 307-275'; pumped in mud, 275-25'; 25 sacks of cement, 25' to surface.

RECEIVED
STATE CORPORATION COMMISSION
JUN 5 1953
06-05-1953
CONSERVATION DIVISION
Wichita, Kansas

(If additional description is necessary, use BACK of this sheet)

Correspondence regarding this well should be addressed to Kingwood Oil Company
Address 613 Cravens Building, Oklahoma City, Oklahoma

STATE OF Oklahoma, COUNTY OF Oklahoma, ss.
Kenneth L. Hibdon (employee of owner) or (owner or operator) of the above-described well, being first duly sworn on oath, says: That I have knowledge of the facts, statements, and matters herein contained and the log of the above-described well as filed and that the same are true and correct. So help me God.

(Signature) Kenneth L. Hibdon
Cravens Building, Oklahoma City, Oklahoma
(Address)

SUBSCRIBED AND SWORN TO before me this 3rd day of June, 1953.

My commission expires July 28, 1953

Marcella Feldhake
Notary Public.

PLUGGING
FILE SEC 11 T 8 R 40a
BOOK PAGE 91 LINE 28

WELL LOG

5-8-52 200.5-00 00

Kingwood Oil Co., Sixth Floor, Cravens Bldg., Oklahoma City, Okl.

and
Aurora Gasoline Co., Wright Building, Tulsa, Oklahoma

SE SE NE
Section 11-8S-40W,
Sherman County, Ks.

G. W. Rauckmann #1

Total Depth: 5573'
Commenced: 6/25/52 Completed: 8/2/52
Contractor: J. D. Ferrell Drilling Co., Inc.
Rotary: 0 - 5573'

Casing Record: 322.98' of 10 3/4" 32.75# casing (14 joints); cemented with 200 sacks Portland cement and 2 sacks calcium chloride; cement circulated.

Figures Indicate Bottoms of Formations:

| | | | |
|-------------------------|-------------|----------------------|------------------|
| Cellar | 0 - 5 | Lime | 4175 - 4235 |
| Sandy Clay | 5 - 60 | Lime and Shale | 4235 - 4280 |
| Sand | 60 - 135 | Lime | 4280 - 4755 |
| Sandy Clay and Shale | 135 - 210 | Shale, Lime & Shells | 4755 - 4775 |
| Water Sand | 210 - 295 | Shale and Lime | 4775 - 4805 |
| Shale | 295 - 930 | Lime | 4805 - 4860 |
| Shale and Shells | 930 - 1195 | Chert and Lime | 4860 - 4880 |
| Lime and Shale | 1195 - 1419 | Lime | 4880 - 5045 |
| Shale | 1419 - 1480 | Lime and Sand | 5045 - 5061 |
| Shale, Lime & Shells | 1480 - 1685 | -Cored- | 5061 - 5075 |
| Lime | 1685 - 1758 | Shale and Sand | 5075 - 5110 |
| Shale and Shells | 1758 - 1840 | Shale | 5110 - 5145 |
| Shale and Lime | 1840 - 1960 | Shale and Lime | 5145 - 5173 |
| Lime | 1960 - 1978 | Lime and Sand | 5173 - 5190 |
| Shale | 1978 - 2095 | Lime | 5190 - 5292 |
| Sand | 2095 - 2200 | Chert, Lime & Pyrite | 5292 - 5305 |
| Shale and Sand | 2200 - 2226 | Lime and Chert | 5305 - 5316 |
| Sand and Shale Streaks | 2226 - 2283 | Lime | 5316 - 5333 |
| Sand and Shale | 2283 - 2335 | Chert and Lime | 5333 - 5344 |
| Shale and Sand | 2335 - 2375 | Lime and Chert | 5344 - 5360 |
| Sand and Shale | 2375 - 2507 | Lime | 5360 - 5372 |
| Sand and Red Bed | 2507 - 2585 | Chert and Lime | 5372 - 5384 |
| Shale and Shells | 2585 - 2640 | Lime | 5384 - 5550 |
| Shale and Sand Streaks | 2640 - 2687 | Sand | 5550 - 5573 T.D. |
| Shale and Anhydrite | 2687 - 2765 | | |
| Anhydrite and Shale | 2765 - 2798 | | |
| Shale | 2798 - 3040 | | |
| Shale and Redbed | 3040 - 3165 | | |
| Shale | 3165 - 3169 | | |
| Anhydrite and Shale | 3169 - 3208 | | |
| Red Bed | 3208 - 3265 | | |
| Red Bed and Anhydrite | 3265 - 3365 | | |
| Anhydrite and Red Bed | 3365 - 3407 | | |
| Red Bed and Shale | 3407 - 3606 | | |
| Red Bed | 3606 - 3605 | | |
| Shale and Red Bed | 3605 - 3670 | | |
| Red Bed and Shale | 3670 - 3720 | | |
| Shale, Lime & Anhydrite | 3720 - 3770 | | |
| Red Bed, Shale & Shells | 3770 - 3800 | | |
| Lime | 3800 - 3845 | | |
| Shale | 3845 - 3875 | | |
| Shale and Lime | 3875 - 3885 | | |
| Lime | 3885 - 4154 | | |
| Lime with oil show | 4154 - 4166 | | |
| Lime and shale w/ show | 4166 - 4175 | | |

Tops:

| | |
|---------------------|------|
| Topeka | 4030 |
| Heebner | 4332 |
| Lansing Kansas City | 4362 |
| Marmaton | 4705 |
| Cherokee | 5051 |
| Mississippi Lime | 5183 |
| Arbuckle | 5472 |
| Regan Sand | 5550 |

We hereby certify this to be a correct and accurate log of the above described well as shown on the Daily Drilling Reports.

J. D. FERRELL DRILLING CO., INC.

Subscribed and sworn to before me this 5th day of August, 1952.

J. J. Ferrell

Notary Public

RECEIVED
STATE CORPORATION COMMISSION
JUN X 5 1953
CONSERVATION DIVISION
Wichita, Kansas.

PLUGGING
FILE SEC 11 T 8 R 40w
BOOK PAGE 91 LINE 28