


STATE OF KANSAS  
STATE CORPORATION COMMISSION

Give All Information Completely  
Make Required Affidavit  
Mail or Deliver Report to:  
Conservation Division  
State Corporation Commission  
800 Bittling Building  
Wichita, Kansas

15-141-00046-0000  
WELL PLUGGING RECORD

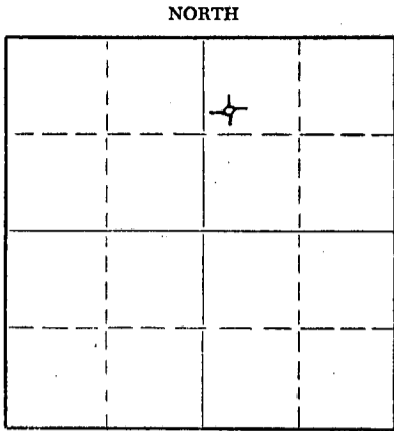

Locate well correctly on above  
Section Plat

Osborne County. Sec. 5 Twp. 9S Rge. 15 (E) W (W)  
Location as "NE/CNW&SWK" or footage from lines SW/4 NW/4 NE/4  
Lease Owner Anderson-Prichard Oil Corp.  
Lease Name Beisner Well No. 1  
Office Address Liberty Bank Bldg. Oklahoma City 2, Oklahoma  
Character of Well (completed as Oil, Gas or Dry Hole) Dry Hole  
Date well completed Jan. 30, 1953  
Application for plugging filed Jan. 30, 1953  
Application for plugging approved Jan. 30, 1953  
Plugging commenced Jan. 30, 1953  
Plugging completed Jan. 30, 1953  
Reason for abandonment of well or producing formation Dry Hole

If a producing well is abandoned, date of last production 19  
Was permission obtained from the Conservation Division or its agents before plugging was commenced? Yes

Name of Conservation Agent who supervised plugging of this well C. D. Stough  
Producing formation \_\_\_\_\_ Depth to top \_\_\_\_\_ Bottom \_\_\_\_\_ Total Depth of Well \_\_\_\_\_ Feet  
Show depth and thickness of all water, oil and gas formations.

OIL, GAS OR WATER RECORDS

CASING RECORD

FORMATION	CONTENT	FROM	TO	SIZE	PUT IN	PULLED OUT
		0	206	8 5/8"	206'	None

Describe in detail the manner in which the well was plugged, indicating where the mud fluid was placed and the method or methods used in introducing it into the hole. If cement or other plugs were used, state the character of same and depth placed, from \_\_\_\_\_ feet to \_\_\_\_\_ feet for each plug set.

3842' - 201 1/2' - Heavy Rotary Mud  
201 1/2' - 200' - Wooden Plug  
200' - 138' - 20 sacks cement  
138' - 41 1/2' - Heavy rotary mud  
41 1/2' - 40' - Wooden Plug  
40' - 6' - 10 sacks cement  
6' - surface - Cellar

(If additional description is necessary, use BACK of this sheet)

Name of Plugging Contractor Glenn W. Peel  
Address P. O. Box 359 Hoisington, Kansas

STATE OF Kansas, COUNTY OF Barton, ss.

Glenn W. Peel (employee of owner) or (owner) of the above-described well, being first duly sworn on oath, says: That I have knowledge of the facts, statements, and matters herein contained and the log of the above-described well as filed and that the same are true and correct. So help me God. GLENN W. PEEL

(Signature) BY: *Glenn W. Peel*  
P. O. Box 359  
Hoisington, Kansas (Address)

SUBSCRIBED AND SWORN to before me this 2nd day of February, 1953

My commission expires June 4, 1955

*Marian M. Herbert*  
Notary Public.

PLUGGING  
FILE SEC 5 T 9 R 15 W  
BOOK PAGE 22 LINE 7

RECEIVED  
STATE CORPORATION COMMISSION  
FEB 4 - 1953  
CONSERVATION DIVISION  
Wichita, Kansas

15-141-00046-00-00

DRILLER'S LOG

Company: Anderson-Prichard Oil Corp.

SW/4, NW/4 NE/4  
Sec. 5, Twp. 9S, Rge. 15W

Farm: Beisner Well No. 1  
Total Depth: 3842'

County: Osborne  
Kansas

Comm: 1-17-53 Comp. 1-30-53

Elevation:

Contractor: Glenn W. Peel

Casing: 8 5/8" 206' Cem.

Production: Dry

Figures below indicate bottom of formation

Surface Clay	0	206
Shale		660
Sand		780
Shale		950
Red Bed & Shale		1075
Shale		1190
Anhydrite		1230
Shale		1475
Shale & Lime		2240
Lime		2605
Lime & Shale		2765
Lime		3842
Total Depth		3842

This is to certify that the above information is, to the best of our knowledge, true and correct.

GLENN W. PEEL.

BY: *Glenn W. Peel*

SUBSCRIBED AND SWORN to before me this 2nd day of February, 1953,  
My commission expires June 4, 1955

*Manuel M. Herbst*  
Notary Public



2-4-53

**RECEIVED**  
STATE CORPORATION COMMISSION  
FEB 4 - 1953  
CONSERVATION DIVISION  
Wichita, Kansas

**PLUGGING**  
FILE SEC 5 T 9 R 15 W  
BOOK PAGE 22 LINE 7