

CARD MUST BE TYPED

State of Kansas

CARD MUST BE SIGNED

NOTICE OF INTENTION TO DRILL

(see rules on reverse side)

CORRECTION

Starting Date 9/22/86
month day year

API Number 15-003-22, 763.00-05 ⁹⁻²²⁻⁸⁶
_____ East

OPERATOR: License # 9102

* W/2 NE SW Sec. 3 Twp. 23 S, Rg. 21 _____ West

Name MICO OIL & GAS

1980 Ft. from South Line of Section

Address P. O. Box 281

* 3740 Ft. from East Line of Section

City/State/Zip Paola, Kansas 66071

(Note: Locate well on Section Plat on reverse side)

Contact Person Ernie Pratt

Nearest lease or unit boundary line 1100 feet

Phone 913 294 4326

County Anderson

CONTRACTOR: License #

Lease Name. McGee Well # 11-86

Name unknown

Ground surface elevation n/a feet MSL

City/State

Domestic well within 330 feet: _____ yes X no

Well Drilled For: Well Class: Type Equipment:

Municipal well within one mile: _____ yes X no

X Oil _____ SWD X Infield X Mud Rotary

Depth to bottom of fresh water 20

_____ Gas _____ Inj _____ Pool Ext. _____ Air Rotary

Depth to bottom of usable water 100

_____ OWWO _____ Expl _____ Wildcat _____ Cable

Surface pipe by Alternate: 1 _____ 2 X

If OWWO: old well info as follows:

Surface pipe planned to be set 20

Operator

Conductor pipe required n/a

Well Name

Projected Total Depth 950 feet

Comp Date Old Total Depth

Formation

I certify that well will comply with K.S.A. 55-101, et seq., plus eventually plugging hole to KCC specifications.

Date 9/22/86 Signature of Operator or Agent Wanda Edmore Title as agent

For KCC Use:

Conductor Pipe Required feet; Minimum Surface Pipe Required 20 feet per Alt. 2

This Authorization Expires 3-18-87 Approved By 9-18-86


Wanda Edmore N/2 SE SW 1100 FSL
3300 FEL

Must be filed with the K.C.C. five (5) days prior to commencing well
 This card void if drilling not started within six (6) months of date received by K.C.C.

Important procedures to follow:

1. Notify District office before setting surface casing.
2. Set surface casing by circulating cement to the top.
3. File completion forms ACO-1 with K.C.C. within 90 days of well completion, following instructions on ACO-1, side 1, and including copies of wireline logs.
4. Notify District office 48 hours prior to old well workover or re-entry.
5. Prior to filing Intent, prepare a proposed plugging plan in case well is D & A, then obtain approval of plan when calling district office prior to setting surface pipe.
6. Submit plugging report (CP-4) to K.C.C. after plugging is completed.
7. Obtain an approved injection docket number before disposing of salt water.
8. Notify K.C.C. within 10 days when injection commences or terminates.

**A Regular Section of Land
 1 Mile = 5,280 Ft.**

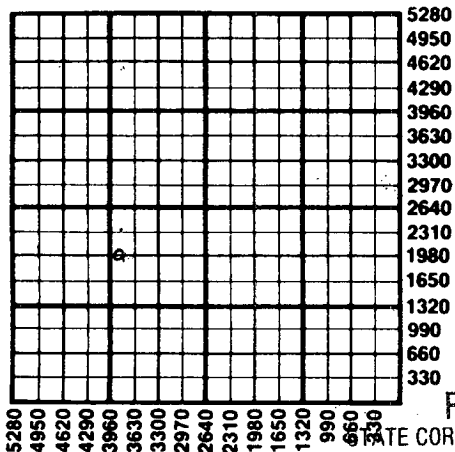

RECEIVED

STATE CORPORATION COMMISSION

SEP 22 1986
 09-22-86
 CONSERVATION DIVISION
 Wichita, Kansas

in alternate 2 completion, cement in the production pipe from below any usable water to surface within 120 days of spud date.

State Corporation Commission of Kansas
 Conservation Division
 200 Colorado Derby Building
 Wichita, Kansas 67202
 (316) 263-3238