

CARD MUST BE TYPED

State of Kansas
NOTICE OF INTENTION TO DRILL
(see rules on reverse side)

CARD MUST BE SIGNED

Starting Date: September 20, 1984
month day year

API Number 15- 065-22,035-00-00

OPERATOR: License # 5267

NE .NW .NW. . . . Sec .35. Twp . . 8. S, Rge . 22 East
(location) West

Name K. & E. Petroleum, Inc.
Address 100 S. Main Suite 300 Hardage Ctr.
City/State/Zip Wichita, Kansas 67202
Contact Person Donald A. Plank
Phone 316-264-4301

4950 Ft North from Southeast Corner of Section
4290 Ft West from Southeast Corner of Section
(Note: Locate well on Section Plat on reverse side)

CONTRACTOR: License # 5422

Nearest lease or unit boundary line 330 feet.

Name Abercrombie Drilling, Inc.
City/State Wichita, Kansas 67202

County Graham
Lease Name Buss Well# 1

Well Drilled For: Well Class: Type Equipment:
 Oil Swd Infield Mud Rotary
 Gas Inj Pool Ext. Air Rotary
 OWWO Expl Wildcat Cable

Domestic well within 330 feet: yes no
Municipal well within one mile: yes no

If OWWO: old well info as follows:

Depth to Bottom of fresh water 280' feet
Lowest usable water formation Dakota
Depth to Bottom of usable water 900-1,000 feet
Surface pipe by Alternate: 1 2

Operator N/A

Well Name

Comp Date Old Total Depth

Projected Total Depth 3850 feet

Surface pipe to be set 360 feet
Conductor pipe if any required None feet
Ground surface elevation 2192 feet MSI

Projected Formation at TD Arbuckle

Expected Producing Formations Arbuckle

This Authorization Expires 7/31/85
Approved By 7/31/84 R

I certify that we will comply with K.S.A. 55-101, et seq., plus eventually plugging hole to K.C.C. specifications.

Date 7-30-84 Signature of Operator or Agent

Donald A. Plank

Title Drilling & Production Mgr.


Form C-1 4/84

2114C/KDHE 7/31/84

Must be filed with the K.C.C. five (5) days prior to commencing well
This card void if drilling not started within six (6) months of date received by K.C.C.

RECEIVED
STATE CORPORATION COMMISSION
JUL 31, 1984
JUL 31 1984

A Regular Section of Land
1 Mile = 5,280 Ft.

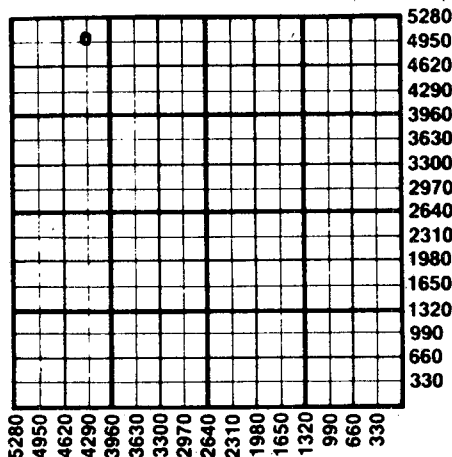

Important procedures to follow:

CONSERVATION DIVISION
Wichita, Kansas

1. Notify District office before setting surface casing.
2. Set surface casing by circulating cement to the top.
3. File completion forms ACO-1 with K.C.C. within 90 days of well completion, following instructions on ACO-1, side 1, and including copies of wireline logs.
4. Notify District office 48 hours prior to old well workover or re-entry.
5. Prior to plugging, prepare a plugging plan, then obtain agreement from the appropriate district office for an approved plugging plan.
6. Submit plugging report (CP-4) to K.C.C. after plugging is completed.
7. Obtain an approved injection docket number before disposing of salt water.
8. Notify K.C.C. within 10 days when injection commences or terminates.
9. If an alternate 2 completion, cement in the production pipe from below any usable water to surface within 120 days of spud date.

State Corporation Commission of Kansas
Conservation Division
200 Colorado Derby Building
Wichita, Kansas 67202
(316) 263-3238