

NOTICE OF INTENTION TO DRILL

(see rules on reverse side)

Starting Date 10-17-86 month day year 11:00

API Number 15- 065-22,330-00-06

OPERATOR: License # 03079
Name A & M Oil Operations
Address 1901 B. E. 24th
City/State/Zip Hays, Kansas 67601
Contact Person A. J. Younger
Phone 913-628-1469

... C S./2 N/2 sec. NW 19 Twp. 8 S, Rg. 22 X West
4290 Ft. from South Line of Section
3960 Ft. from East Line of Section

(Note: Locate well on Section Plat on reverse side)

CONTRACTOR: License # 9087
Name R & C Drilling Co., Inc.
City/State Box 296, Hays, Ks. 67601

Nearest lease or unit boundary line 990 feet
County Graham
Lease Name Quint Well # C-1

Well Drilled For: Well Class: Type Equipment:
X Oil SWD Infield X Mud Rotary
Gas Inj Pool Ext Air Rotary
OWWO Expl Wildcat Cable

Ground surface elevation 2131 feet MSL
Domestic well within 330 feet: yes X no
Municipal well within one mile: X yes no

If OWWO: old well info as follows:

Operator
Well Name
Comp Date Old Total Depth

Depth to bottom of fresh water 200
Depth to bottom of usable water 1225-1100
Surface pipe by Alternate: 1 2 X
Surface pipe planned to be set 210-220
Conductor pipe required n/a
Projected Total Depth 3700 feet
Formation Kansas City

I certify that well will comply with K.S.A. 55-101, et seq., plus eventually plugging hole to KCC specifications.

Date 10-16-86 Signature of Operator or Agent Anna Elmore Title As Agent

For KCC Use:

Conductor Pipe Required 220 feet; Minimum Surface Pipe Required 220 feet per An.
This Authorization Expires 4-16-87 Approved By 10-16-86


Signature and initials: PCA/KCC

Must be filed with the K.C.C. five (5) days prior to commencing well
This card void if drilling not started within six (6) months of date received by K.C.C.

Important procedures to follow:

1. Notify District office before setting surface casing.
2. Set surface casing by circulating cement to the top.
3. File completion forms ACO-1 with K.C.C. within 90 days of well completion, following instructions on ACO-1, side 1, and including copies of wireline logs.
4. Notify District office 48 hours prior to old well workover or re-entry.
5. Prior to filing Intent, prepare a proposed plugging plan in case well is D & A, then obtain approval of plan when calling district office prior to setting surface pipe.
6. Submit plugging report (CP-4) to K.C.C. after plugging is completed.
7. Obtain an approved injection docket number before disposing of salt water.
8. Notify K.C.C. within 10 days when injection commences or terminates.

**A Regular Section of Land
1 Mile = 5,280 Ft.**

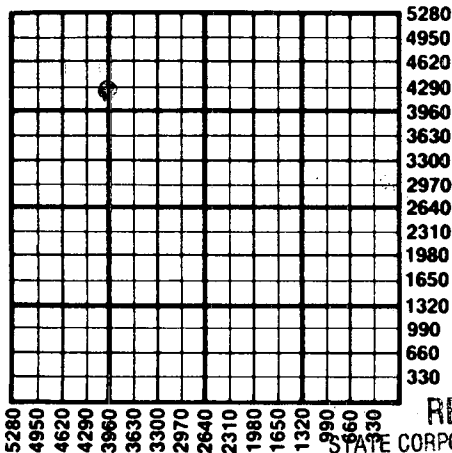

RECEIVED
CORPORATION COMMISSION

OCT 16 1986
OCT 16, 1986
CONSERVATION DIVISION
Wichita, Kansas

an alternate 2 completion, cement in the production pipe from below any usable water to surface within 120 days of spud date.

State Corporation Commission of Kansas
Conservation Division
200 Colorado Derby Building
Wichita, Kansas 67202
(316) 263-3238