

NOTICE OF INTENTION TO DRILL

(see rules on reverse side)

CORRECTED - FOOTNOTED 5-5-87 reported incorrectly

8

Starting Date 4-29-87 month day year

API Number 15- 065-22,369 -00-00

OPERATOR: License # 6139 Name Jay C. Boyer Address P. O. Box 511 City/State/Zip Hays, Kansas 67601 Contact Person Jay C. Boyer Phone 913-625-6967

* C. NE NW NW Sec. 19 Twp. 8 S, Rg. 22 X West * 4950 Ft. from South Line of Section * 4290 Ft. from East Line of Section

(Note: Locate well on Section Plat on reverse side)

CONTRACTOR: License # 4083 Name Western Kansas Drilling, Inc. City/State Hays, Kansas 67601

Nearest lease or unit boundary line 330 feet County Graham

Lease Name Quint "C" Well # 4 Ground surface elevation 2124 feet MSL

Well Drilled For: X Oil SWD X Infield X Mud Rotary Gas Inj Pool Ext Air Rotary OWWO Expl Wildcat Cable

Domestic well within 330 feet: yes X no Municipal well within one mile: yes X no Surface pipe by Alternate: 1 2 X 3 Depth to bottom of fresh water 160 Depth to bottom of usable water 1100 Surface pipe planned to be set 212 Projected Total Depth 3650 feet Formation KC

If OWWO: old well info as follows:

Operator Well Name Comp Date Old Total Depth

I certify that well will comply with K.S.A. 55-101, et seq., plus eventually plugging hole to KCC specifications. Alternate cementing will be done immediately upon setting production casing. Date 5-4-87 Signature of Operator or Agent Jay C. Boyer Title Operator


For KCC Use:

Conductor Pipe Required feet; Minimum Surface Pipe Required 100 feet per Alt. 100 This Authorization Expires 10-27-87 Approved By 4-27-87

Must be filed with the K.C.C. five (5) days prior to commencing well
 This card void if drilling not started within six (6) months of date received by K.C.C.

Important procedures to follow:

A Regular Section of Land
1 Mile = 5,280 Ft.

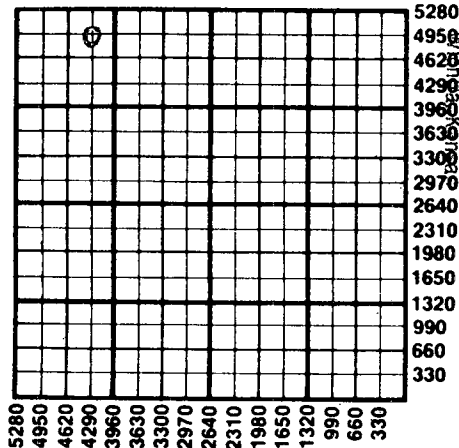

RECEIVED
 MAY 5 1987
 CONSERVATION DIVISION
 MAY 5 1987

1. Notify District office before setting surface casing.
2. Set surface casing by circulating cement to the top.
3. File completion forms ACO-1 with K.C.C. within 90 days of well completion, following instructions on ACO-1, side 1, and including copies of wireline logs.
4. Notify District office 48 hours prior to old well workover or re-entry.
5. Prior to filing Intent, prepare a proposed plugging plan in case well is & A, then obtain approval of plan when calling district office prior to setting surface pipe.
6. Submit plugging report (CP-4) to K.C.C. after plugging is completed.
7. Obtain an approved injection docket number before disposing of salt water.
8. Notify K.C.C. within 10 days when injection commences or terminates.
9. If an alternate 2 completion, cement in the production pipe from below any usable water to surface within 120 days of spud date.

State Corporation Commission of Kansas
 Conservation Division
 200 Colorado Derby Building
 Wichita, Kansas 67202
 (316) 263-3238