

CARD MUST BE TYPED

State of Kansas

CARD MUST BE SIGNED

# NOTICE OF INTENTION TO DRILL

(see rules on reverse side)

Starting Date 9-5-87  
month day year

API Number 15— 065-22,402-00-00 East

OPERATOR: License # 6139  
Name Jay C. Boyer  
Address P. O. Box 511  
City/State/Zip Hays, Kansas 67601  
Contact Person Jay C. Boyer  
Phone 913-625-6967

NE-SW-NW Sec. 19 Twp. 8S S, Rg. 22  East  
 West  
3630 Ft. from South Line of Section  
4290 Ft. from East Line of Section

(Note: Locate well on Section Plat on reverse side)

CONTRACTOR: License # 4083  
Name Western Kansas Drilling, Inc.  
City/State Hays, Kansas 67601

Nearest lease or unit boundary line 330 feet  
County Graham

Lease Name Quint "B" Well # 4  
Ground surface elevation 2133 feet MSL

Well Drilled For: Well Class: Type Equipment:  
 Oil  SWD  Infield  Mud Rotary  
 Gas  Inj  Pool Ext.  Air Rotary  
 OWWO  Expl  Wildcat  Cable

Domestic well within 330 feet:  yes  no  
Municipal well within one mile:  yes  no  
Surface pipe by Alternate:  1  2  3  
Depth to bottom of fresh water 160  
Depth to bottom of usable water 1100  
Surface pipe planned to be set 212  
Projected Total Depth 3650 feet  
Formation KC

If OWWO: old well info as follows:

Operator .....  
Well Name .....  
Comp Date ..... Old Total Depth .....

I certify that well will comply with K.S.A. 55-101, et seq., plus eventually plugging hole to KCC specifications.

~~Alternate 3~~ cementing will be done immediately upon setting production casing.

Date 8-31-87 Signature of Operator or Agent Jay C. Boyer Title Operator

For KCC Use:

Conductor Pipe Required ..... feet; Minimum Surface Pipe Required 200 feet per Alt.


This Authorization Expires 3-7-88 / Effective 9-7-87 Approved By 9-2-87

Must be filed with the K.C.C. five (5) days prior to commencing well  
This card void if drilling not started within six (6) months of date received by K.C.C.

### Important procedures to follow:

1. Notify District office before setting surface casing.
2. Set surface casing by circulating cement to the top.
3. File completion forms ACO-1 with K.C.C. within 90 days of well completion, following instructions on ACO-1, side 1, and including copies of wireline logs.
4. Notify District office 48 hours prior to old well workover or re-entry.
5. Prior to filing Intent, prepare a proposed plugging plan in case well is D & A, then obtain approval of plan when calling district office prior to setting surface pipe.
6. Submit plugging report (CP-4) to K.C.C. after plugging is completed.
7. Obtain an approved injection docket number before disposing of salt water.
8. Notify K.C.C. within 10 days when injection commences or terminates.
9. If an alternate 2 completion, cement in the production pipe from below any usable water to surface within 120 days of spud date.

### A Regular Section of Land 1 Mile = 5,280 Ft.

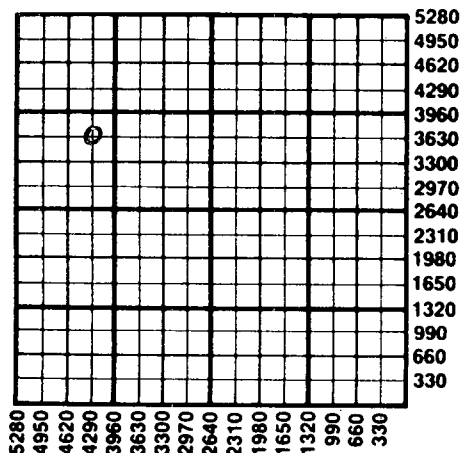

RECEIVED  
STATE CORPORATION COMMISSION

SEP 1 1987  
State Corporation Commission of Kansas  
Conservation Division  
200 Colorado Derby Building  
Wichita, Kansas 67202  
(316) 263-3238