

CARD MUST BE TYPED

State of Kansas
NOTICE OF INTENTION TO DRILL

CARD MUST BE SIGNED

(see rules on reverse side)

Starting Date: JULY 31 1984
month day year

API Number 15- 065-22,031-00-00

OPERATOR: License # 5430
Name ENERGY THREE, INC.
Address P.O. Box 1505
City/State/Zip GREAT BEND, KANSAS 67530
Contact Person DOUGLAS MEYER
Phone AC316-792-5968

SE. SW. SE ... Sec. 29 Twp. 8 S, Rge. 22 East
(location) West

330 Ft North from Southeast Corner of Section
1650 Ft West from Southeast Corner of Section
(Note: Locate well on Section Plat on reverse side)

CONTRACTOR: License # 5836
Name BIG THREE DRILLING, INC.
City/State P.O. Box 52, GORHAM, KS, 67640

Nearest lease or unit boundary line 330 feet.
County GRAHAM

Lease Name JOHN MOORE Well# 1

Domestic well within 330 feet: yes no

Municipal well within one mile: yes no

Well Drilled For: Well Class: Type Equipment:
 Oil Swd Infield Mud Rotary
 Gas Inj Pool Ext. Air Rotary
 OWWO Expl Wildcat Cable

Depth to Bottom of fresh water 80 feet

Lowest usable water formation DAKOTA

Depth to Bottom of usable water 1000 1100 feet

Surface pipe by Alternate: 1 2

Surface pipe to be set 240 feet

Conductor pipe if any required _____ feet

Ground surface elevation _____ feet MSL

This Authorization Expires 1/25/85

Approved By 7/25/84 PC

If OWWO: old well info as follows:

Operator _____

Well Name _____

Comp Date _____ Old Total Depth _____

Projected Total Depth 3850 feet

Projected Formation at TD ARBUCKLE

Expected Producing Formations ARBUCKLE; L-KC

I certify that we will comply with K.S.A. 55-101, et seq., plus eventually plugging hole to K.C.C. specifications.

Date 7-24-84 Signature of Operator or Agent

Douglas P Meyer


Title EXEC. VICE-PRESIDENT

mHC/KOHE 7/25/84

RECEIVED
 CORPORATION COMMISSION
 STATE OF KANSAS
 JUL 25 1984
 JUL 25 1984
 CONSERVATION DIVISION
 WICHITA, KANSAS

Must be filed with the K.C.C. five (5) days prior to commencing well
 This card void if drilling not started within six (6) months of date received by K.C.C.

Regular Section of Land
 1 Mile = 5,280 Ft.

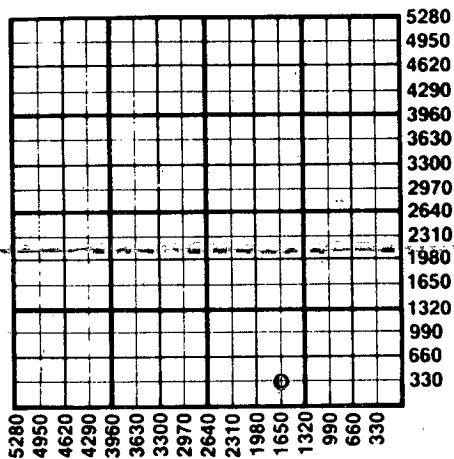

Important procedures to follow :

1. Notify District office before setting surface casing.
2. Set surface casing by circulating cement to the top.
3. File completion forms ACO-1 with K.C.C. within 90 days of well completion, following instructions on ACO-1, side 1, and including copies of wireline logs.
4. Notify District office 48 hours prior to old well workover or re-entry.
5. Prior to plugging, prepare a plugging plan, then obtain agreement from the appropriate district office for an approved plugging plan.
6. Submit plugging report (CP-4) to K.C.C. after plugging is completed.
7. Obtain an approved injection docket number before disposing of salt water.
8. Notify K.C.C. within 10 days when injection commences or terminates.
9. If an alternate 2 completion, cement in the production pipe from below any usable water to surface within 120 days of spud date.

State Corporation Commission of Kansas
 Conservation Division
 200 Colorado Derby Building
 Wichita, Kansas 67202
 (316) 263-3238