

CARD MUST BE TYPED

State of Kansas
NOTICE OF INTENTION TO DRILL

CARD MUST BE SIGNED

(see rules on reverse side)

Starting Date: May 10 1985
month day year

API Number 15- 065-22,178-00-00

OPERATOR: License # 5027

NW. NW. SW. Sec 33. Twp 8 S, Rge 25
(location) East West

Name J. A. Allison

Address 300 West Douglas, Suite 305

City/State/Zip Wichita, Kansas 67202

Contact Person J. A. Allison

Phone 316-263-2241

2310 Ft North from Southeast Corner of Section

4950 Ft West from Southeast Corner of Section

(Note: Locate well on Section Plat on reverse side)

CONTRACTOR: License # 5110

Name B & B Drilling, Inc.

City/State 515 Union Center, Wichita, Ks. 67202

Nearest lease or unit boundary line 330 feet.

County GRAHAM

Lease Name ST. JOHN Well# 1

Domestic well within 330 feet: yes no

Municipal well within one mile: yes no

Well Drilled For: Well Class: Type Equipment:

- Oil Swd Infield Mud Rotary
- Gas Inj Pool Ext. Air Rotary
- OWWO Expl Wildcat Cable

Depth to Bottom of fresh water 135 feet

Lowest usable water formation Cedar Hills Dakota

Depth to Bottom of usable water 550-1300 feet

Surface pipe by Alternate: 1 2

Surface pipe to be set 225 feet

Conductor pipe if any required None feet

Ground surface elevation 2500 feet MSI.

This Authorization Expires 10-19-85

Approved By 4-19-85 R

If OWWO: old well info as follows:

Operator

Well Name

Comp Date Old Total Depth

Projected Total Depth 4060 feet

Projected Formation at TD Base Kansas City

Expected Producing Formations Lansing - Kansas City

I certify that we will comply with K.S.A. 55-101, et seq., plus eventually plugging hole to K.C.C. specifications.

Date April 18, 1985 Signature of Operator or Agent

J. A. Allison


Title Operator

mitc/KOHE 4-19-85

**Must be filed with the K.C.C. five (5) days prior to commencing well
This card void if drilling not started within six (6) months of date received by K.C.C.**

Important procedures to follow :

**A Regular Section of Land
1 Mile = 5,280 Ft.**

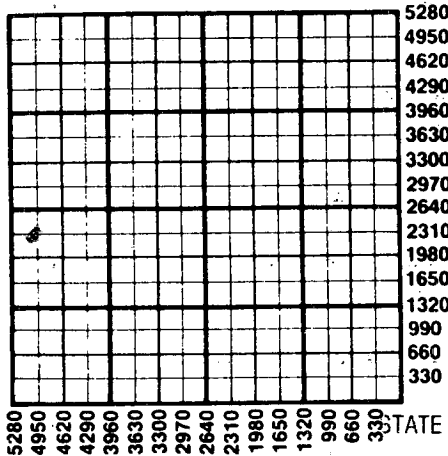

1. Notify District office before setting surface casing.
2. Set surface casing by circulating cement to the top.
3. File completion forms ACO-1 with K.C.C. within 90 days of well completion, following instructions on ACO-1, side 1, and including copies of wireline logs.
4. Notify District office 48 hours prior to old well workover or re-entry.
5. Prior to plugging, prepare a plugging plan, then obtain agreement from the appropriate district office for an approved plugging plan.
6. Submit plugging report (CP-4) to K.C.C. after plugging is completed.
7. Obtain an approved injection docket number before disposing of salt water.
8. Notify K.C.C. within 10 days when injection commences or terminates.
9. If an alternate 2 completion, cement in the production pipe from below any usable water to surface within 120 days of spud date.

RECEIVED

STATE CORPORATION COMMISSION

**State Corporation Commission of Kansas
Conservation Division
200 Colorado Derby Building
Wichita, Kansas 67202
(316) 263-3238**

APR 19 1985
4-19-85
CONSERVATION DIVISION
Wichita, Kansas