

CARD MUST BE TYPED

State of Kansas
NOTICE OF INTENTION TO DRILL

CARD MUST BE SIGNED

(see rules on reverse side)

Starting Date: AUGUST 22 1984
month day year

API Number 15- 065-22,049-00-00

OPERATOR: License # 5430

NW NW NW Sec 35 Twp 8 S, Rge 25 East West
(location)

Name ENERGY THREE, INC.

Address P. O. Box 1505

City/State/Zip GREAT BEND, KS. 67530

Contact Person DOUGLAS MEYER

Phone AC316-792-5968

CONTRACTOR: License # 5836

Name BIG THREE DRILLING, INC.

City/State P.O. BOX 52, GORHAM, KANSAS 67640

4950 Ft North from Southeast Corner of Section

4950 Ft West from Southeast Corner of Section

(Note: Locate well on Section Plat on reverse side)

Nearest lease or unit boundary line 330 feet.

County GRAHAM

Lease Name: TOLL Well# 1

Domestic well within 330 feet: yes no

Municipal well within one mile: yes no

Well Drilled For: Well Class: Type Equipment:

- Oil Swd Infield Mud Rotary
- Gas Inj Pool Ext. Air Rotary
- OWWO Expl Wildcat Cable

If OWWO: old well info as follows:

Operator

Well Name

Comp Date Old Total Depth

Projected Total Depth 4000 feet

Projected Formation at TD LANSING-KC

Expected Producing Formations LANSING-KC

Depth to Bottom of fresh water 175 feet

Lowest usable water formation DAKOTA

Depth to Bottom of usable water 1250 1300 feet

Surface pipe by Alternate: 1 2

Surface pipe to be set 240 feet

Conductor pipe if any required feet

Ground surface elevation feet MSI.

This Authorization Expires 2-16-85

Approved By 8-16-84

I certify that we will comply with K.S.A. 55-101, et seq., plus eventually plugging hole to K.C.C. specifications.

Date 8-15-84 Signature of Operator or Agent Douglas P Meyer


Title EXEC. VICE-PRESIDENT

mhc/KOHE 8/16/84

Must be filed with the K.C.C. five (5) days prior to commencing well
This card void if drilling not started within six (6) months of date received by K.C.C.

Important procedures to follow :

**A Regular Section of Land
1 Mile = 5,280 Ft.**

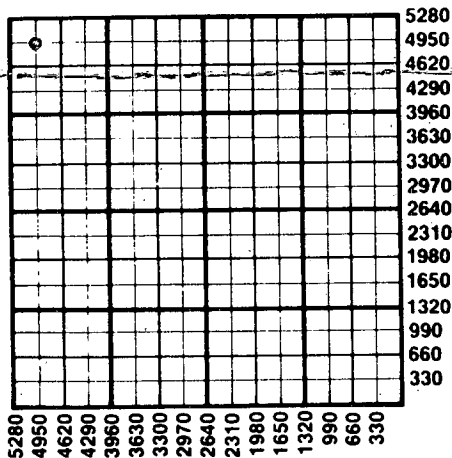

1. Notify District office before setting surface casing.
2. Set surface casing by circulating cement to the top.
3. File completion forms ACO-1 with K.C.C. within 90 days of well completion, following instructions on ACO-1, side 1, and including copies of wireline logs.
4. Notify District office 48 hours prior to old well workover or re-entry.
5. Prior to plugging, prepare a plugging plan, then obtain agreement from the appropriate district office for an approved plugging plan.
6. Submit plugging report (CP-4) to K.C.C. after plugging is completed.
7. Obtain an approved injection docket number before disposing of salt water.
8. Notify K.C.C. within 10 days when injection commences or terminates.
9. If an alternate 2 completion, cement in the production pipe from below any usable water to surface within 120 days of spud date.

State Corporation Commission of Kansas

Conservation Division

200 Colorado Derby Building

Wichita, Kansas 67202

(316) 263-3238

RECEIVED
STATE CORPORATION COMMISSION

AUG 16 1984

8-16-84
CONSERVATION DIVISION
Wichita, Kansas